

**MISSISSIPPI DEPARTMENT OF ENVIRONMENTAL
QUALITY**

Office of Land and Water Resources

P. O. Box 10631
Jackson, MS 39289-0631
WATER WELL DRILLERS LOG

COUNTY WELL LOCATED TATE	
WELL NUMBER 2054	CODED
DATE WELL COMPLETED 2-4-98	

PERMIT NUMBER HICK WATER WELL CO.
NAME OF DRILLING FIRM 30242 HWY. 4 EAST
SENATOBIA, MS 38668

NAME & MAILING ADDRESS OF LANDOWNER
VERNICE Brooks
1000 Jackson Rd.
Senatobia, MS 38668

WELL LOCATION: SEC **8** TOWNSHIP **6 N** RANGE **5 E**

DISTANCE **2** Miles DIRECTION **SW** of NEAREST TOWN **Tyro**

OTHER LANDMARK

WELL PURPOSE: Home, Irrigation, Municipal, Industrial, Fish Pond, etc.

PUMP DATA

PUMP TYPE (Circle One): Submersible Turbine, Jet, Flowing Well, Other (Describe)

POWER TYPE (Circle One): Electric Tractor, Diesel, Gasoline **3/4**, Butane, Other (Describe) **H/P**

Pump Capacity (GPM) 12	No. of Stages	Setting Depth 200 FT.
----------------------------------	---------------	---------------------------------

PUMP TEST

Well yielded _____ GPM with a drawdown of no ft. after _____ hours of pumping

WELL DATA

Well Depth. 206	Casing Diameter (In.) 4	Casing Length (Ft.) 196
Type of Casing PVC	Hole Depth 206	Depth to Static Water Level 160

TYPE OF COMPLETION: (Circle One or More): Gravel Packed, Underreamed, Telescoped, Natural Development, Open Hole, Other (Describe)

WELL GROUTED TO A DEPTH OF **3** FEET
Type Grout (circle one) Cement, Bentonite, or Mix

LOG DATA

TYPE OF LOG RUN (Circle One): No Log Run, Electric, Gamma Ray, Density, Sonic, Neutron, Other (Describe)

Name of Organization Running Log

SCREEN DATA

Diameter - Inches 4	Length - Feet 10'	Slot Size - Inches .013
Screen Type PVC slot	Depth to Bottom - Feet 196	

GEOLOGIC DATA (Office Use Only)

Surface Elev.	Geologic Unit	Unit Thickness	Depth to Top
Subs. SWL	Date	Analysis	Aquifer Test

Driller's Remarks

Top of Lap Pipe or Reduction in Casing


FEET IF TELESCOPED OR MORE THAN ONE SCREEN: USE BACK PAGE

DESCRIPTION OF FORMATIONS ENCOUNTERED	FROM	TO	FORMATIONS (Continued)	FROM	TO
Red Clay	0	10			
White Sand	10	150			
White Clay	150	160			
White Sand	160	206			

IF MORE SPACE IS NEEDED, USE BACK

If well telescopes please
sketch and show depths.

GROUND LEVEL

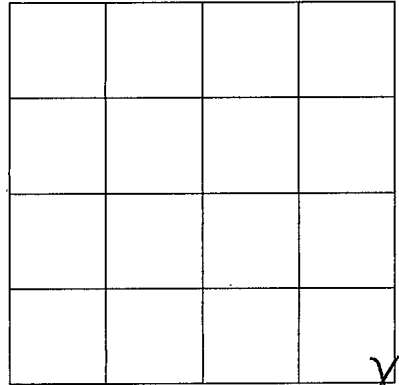

SECTION B

Please indicate well location X.

ADDITIONAL INFORMATION

If more than one screen,
show location of each on sketch.