

MISSISSIPPI DEPARTMENT OF NATURAL RESOURCES

Bureau of Land and Water Resources

Southport Mall

P.O. Box 10631

Jackson, Mississippi 39209

WATER WELL DRILLERS LOG

A.  
Lujan  
5-30-85

5/30/85  
date well completed

Wilson Well Co. Inc.  
firm name

Jippek  
county well located

LANDOWNER: Faulk Property

4729 Spottswood

Memphis, Tenn -  
(mailing address)

WELL LOCATION:

sec. 10 T N R E  
S W  
10 miles NW of Walnut  
(distance) (direction) (nearest town)

WELL PURPOSE: None  
(home, irrigation, municipal, industrial)

WELL COMPLETION DATA:

- (1) diameter (inches) 4
- (2) total depth (feet) 370
- (3) static water level (feet) 130 below above top of ground.
- (4) casing PVC, 330  
(material) (depth)  
4 if telescope see back.  
(size)
- (5) screen 40, PVC  
(length) (depth to top)  
4, PVC  
(size) (material)
- (6) pump 5, 40-50  
(HP) (yield gpm)  
Clint  
(type power)
- (7) electric log no  
(yes or no)  
(organization running log)
- (8) how well bottom plugged 4" pipe Cap.

description of formations encountered

from to


<u>Brown Clay</u>	<u>0</u>	<u>3</u>
<u>White Clay</u>	<u>3</u>	<u>45</u>
<u>Blue Clay</u>	<u>45</u>	<u>68</u>
<u>Rock</u>	<u>68</u>	<u>70</u>
<u>Blue Clay</u>	<u>70</u>	<u>116</u>
<u>Rock</u>	<u>116</u>	<u>118</u>
<u>Blue Clay</u>	<u>118</u>	<u>143</u>
<u>Rock</u>	<u>143</u>	<u>144</u>
<u>Blue Clay</u>	<u>144</u>	<u>145</u>
<u>Rock</u>	<u>145</u>	<u>147</u>
<u>White Sand</u>	<u>147</u>	<u>180</u>
<u>Blue Clay - white sand</u>	<u>180</u>	<u>195</u>
<u>Blue Clay</u>	<u>195</u>	<u>295</u>
<u>Blue Clay - Rock</u>	<u>295</u>	<u>300</u>
<u>Rock</u>	<u>300</u>	<u>310</u>
<u>White Sand</u>	<u>310</u>	<u>312</u>
<u>Blue Clay - Rock</u>	<u>312</u>	<u>315</u>
<u>Rock - White Sand</u>	<u>315</u>	<u>320</u>
<u>Rock - White Sand - Blue Clay</u>	<u>320</u>	<u>327</u>
<u>Blue Clay</u>	<u>327</u>	<u>335</u>
<u>Blue Clay - Rock - White Sand</u>	<u>335</u>	<u>345</u>
<u>Gravel Sand</u>	<u>345</u>	<u>370</u>

DRILLERS REMARKS:

7/17/85-m

If well telescopes please sketch and show depths.

GROUND LEVEL

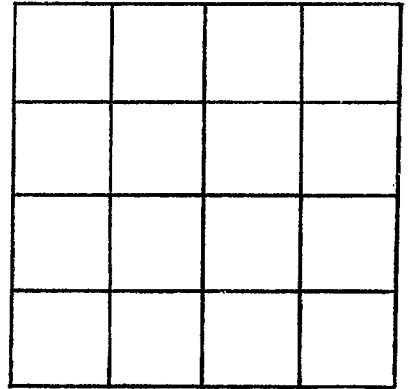

SECTION \_\_\_\_\_

Please indicate well location X.

ADDITIONAL INFORMATION

If more than one screen,  
show locations of each on sketch.