

150

MISSISSIPPI BOARD OF WATER COMMISSIONERS CODED
416 North State Street
Jackson, Mississippi 39201

Zippah
A7
12-15-68

WATER WELL DRILLERS LOG

12-15-1966 date well completed
Jensen Cabel Co. firm name
Zippah county well located

LANDOWNER:

Jim Reed
Walnut Miss.
(mailing address)

description of formations encountered

from to

Sand 0 100

Sand + Rock Formation 100 180

WELL LOCATION:

sec 21 T 1 N R 3 E
S S E
5 miles west of Walnut
(distance) (direction) (nearest town)

WELL PURPOSE: Home
(home, irrigation, municipal, industrial)

WELL COMPLETION DATA:

CODED

(1) diameter (inches) 4"

(2) total depth (feet) 180

(3) static water level (feet) 90 below top of ground

(4) casing PVC 150
(material) (depth)

4" if telescope see back.
(size)

(5) screen 15 165
(length) (depth to top)

1/32 Dome
(size) (material)

(6) pump 1 10
(HP) (yield gpm)

Elec.
(type power)

(7) electric log 0
(yes or no)

0
(organization running log)

(8) how well bottom plugged PVC Cap

DRILLERS REMARKS:

DEC 4 0 1968

MISS. Bd. OF WATER COMMISSIONERS


If well telescopes please sketch and show depths.

GROUND LEVEL

4"
~~150ft~~

165

Screen
~~15ft~~

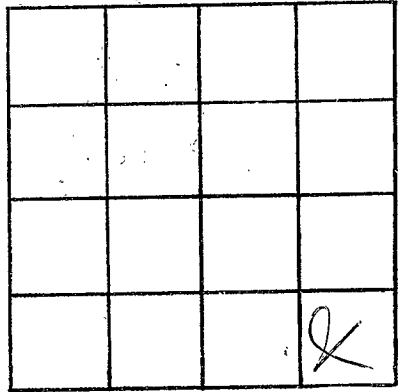

SECTION 21

Please indicate well location X.

ADDITIONAL INFORMATION

If more than one screen, show locations of each on sketch.