

**MISSISSIPPI  
BOARD OF WATER COMMISSIONERS**  
416 North State Street  
Jackson, Mississippi 39201

**CODED**

**WATER WELL DRILLERS LOG**

Tippah
A-8
6-69

date well completed 6/1 1969 firm name J. T. Walker county well located Tippah

LANDOWNER: Mark Gordon

description of formations encountered

from to

without mining  
RA-2  
(mailing address)

loam  
Blue & black  
Rock + gravel  
from 0 to 105  
105 200

WELL LOCATION:

35 sec. 0 T. 0 N. 1 S. R. 3 E.  
6 miles W of Tippah  
(distance) (direction) (nearest town)

WELL PURPOSE:

(home, irrigation, municipal, industrial)

WELL COMPLETION DATA:


- (1) diameter (inches) 3"
- (2) total depth (feet) 200
- (3) static water level (feet) 80 below above top of ground.
- (4) casing P (material) (depth) 5' (size) If telescope see back.
- (5) screen (length) (depth to top) (size) (material)
- (6) pump 1/2 HP (HP) (yield gpm) (type power)
- (7) electric log (yes or no) (organization running log)
- (8) how well bottom plugged

DRILLERS REMARKS:

14 10/11  
MISS. DEP. OF  
WATER RESOURCES

If well telescopes please sketch and show depths.

GROUND LEVEL

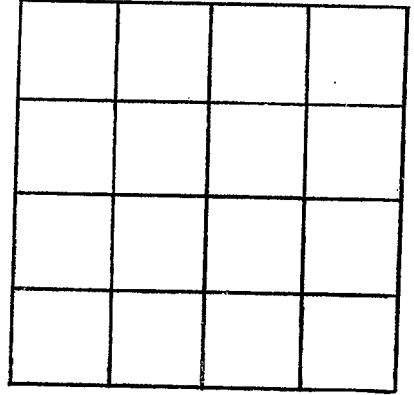

SECTION \_\_\_\_\_

Please indicate well location X.

ADDITIONAL INFORMATION

If more than one screen,  
show locations of each on sketch.