

TIPPAH  
A 10  
12-16-70

MISSISSIPPI  
BOARD OF WATER COMMISSIONERS  
416 North State Street  
Jackson, Mississippi 39201

**CODED**

WATER WELL DRILLERS LOG

12-16 1970 date well completed  
J T Medler firm name  
Tippecanoe county well located

LANDOWNER: C. S. Rowland  
Walnut R#3

description of formations encountered

from to

(mailing address)

WELL LOCATION:

sec. 25 T 1 N R 3 E  
4 miles N.E. of Walnut  
(distance) (direction) (nearest town)

Clay	0	14
Blue clay	14	128
Sand	128	137
Blue "	137	190
Rock	190	225
Sand	225	228
Blue "	228	237
Sand	237	275
Blue "	275	280

WELL PURPOSE:

(home, irrigation, municipal, industrial)

WELL COMPLETION DATA:

- (1) diameter (inches) 4
- (2) total depth (feet) 280
- (3) static water level (feet) 117 below top of ground.
- (4) casing P 280 (material) (depth) If telescope see back.
- (5) screen 20 240 (length) (depth to top) (size) (material)
- (6) pump 1/2 8 (HP) (yield gpm) (type power)
- (7) electric log (yes or no) (organization running log)
- (8) how well bottom plugged Blue


**CODED**

JAN 4 - 1971


DRILLERS REMARKS:

MISS. Bd. OF  
WATER COMMISSIONERS

If well telescopes please sketch and show depths.

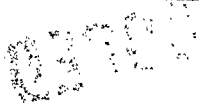

GROUND LEVEL

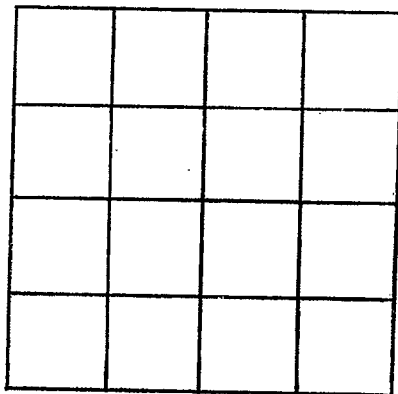

SECTION \_\_\_\_\_

Please indicate well location X.

ADDITIONAL INFORMATION

If more than one screen,  
show locations of each on sketch.