

TIPPAH
 All
 3-15-71

MISSISSIPPI
 BOARD OF WATER COMMISSIONERS
 416 North State Street
 Jackson, Mississippi 39201

WATER WELL DRILLERS LOG

CODED

3-15-1971 date well completed Robert W Wilson firm name Tippah county well located

LANDOWNER: <u>E.E. Martindale</u>	description of formations encountered	from	to
<u>Walnut, Miss</u> (mailing address)	<u>Top Clay White Clay</u>	<u>0</u>	<u>12</u>
	<u>White Clay & Sand</u>	<u>12</u>	<u>15</u>
WELL LOCATION: sec. <u>35</u> T <u>1</u> N R <u>3E</u> <u>(S)</u> <u>(W)</u>	<u>Blue Clay & Sand</u>	<u>15</u>	<u>32</u>
	<u>Blue Clay</u>	<u>32</u>	<u>147</u>
(distance) miles of (direction) (nearest town)	<u>Hard Rock</u>	<u>147</u>	<u>154</u>
WELL PURPOSE: (home, irrigation, municipal, industrial)	<u>Gray Sand & Clay</u>	<u>154</u>	<u>160</u>
WELL COMPLETION DATA:	<u>Gray Sand</u>	<u>160</u>	<u>188</u>
(1) diameter (inches) <u>4</u>			
(2) total depth (feet) <u>188</u>			
(3) static water level (feet) <u>150</u> below top of ground.			
(4) casing <u>Plastic</u> , <u>178</u> (material) (depth)			
<u>4</u> If telescope see back. (size)			
(5) screen <u>10</u> <u>178</u> (length) (depth to top)			
<u>4</u> <u>Stalled pipe</u> (size) (material)			
(6) pump <u>1</u> <u>18</u> (HP) (yield gpm)			
<u>Electric</u> (type power)			
(7) electric log <u>yes or no</u>			
(organization running log)			
(8) how well bottom plugged <u>4"</u> <u>Plastic Cap</u>			
DRILLERS REMARKS:			


CODED

ADD 1 A 1071
 APR 1 1971

MISS. BD. OF
 WATER COMMISSIONERS

If well telescopes please sketch and show depths.

GROUND LEVEL

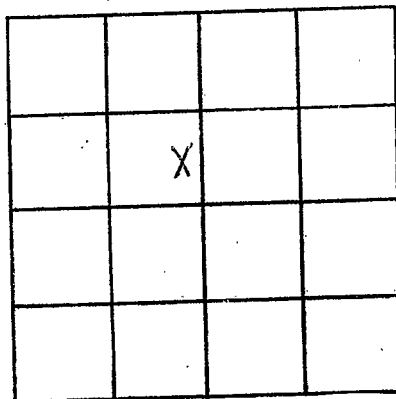

SECTION 35

Please indicate well location X.

ADDITIONAL INFORMATION

If more than one screen, show locations of each on sketch.