

Tippah
A13
6-66

MISSISSIPPI
BOARD OF WATER COMMISSIONERS
416 North State Street
Jackson, Mississippi 39201

WATER WELL DRILLERS LOG

6-20 1966 Robert M. Wilson Tippah
date well completed firm name county well located

LANDOWNER: Leo Smith

description of formations encountered

from to

Walnut

Red dirt

0 10

Miss.

Red Sand

10 20

(mailing address)

White Sand

20 39


WELL LOCATION:

sec 20 T 1 N R 3 E
S W Warner Lake
(distance) (direction) (nearest town)

WELL PURPOSE: home
(home, irrigation, municipal, industrial)

WELL COMPLETION DATA:

- (1) diameter (inches) 4"
- (2) total depth (feet) 39'
- (3) static water level (feet) 39' below above top of ground.
- (4) casing 4" (material), 35' (depth), 4" (size) if telescope see back.
- (5) screen 4' (length), 35' (depth to top), 20 gal (material), 4" (size), Plastic Gnd. Pac (material)
- (6) pump 1/3 (HP), (yield gpm), Elect. (type power)
- (7) electric log NO (yes or no)
- (organization running log)
- (8) how well bottom plugged: 4" plastic cap

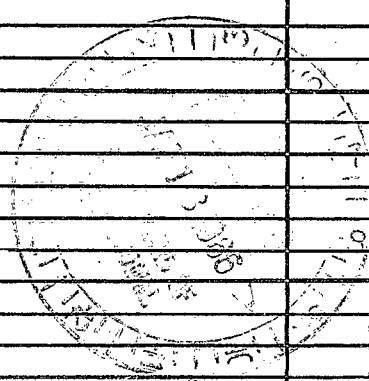

DRILLERS REMARKS:

If well telescopes please sketch and show depths.

GROUND LEVEL

SECTION _____

Please indicate well location X.

ADDITIONAL INFORMATION

If more than one screen, show locations of each on sketch.