

Tippah
 A14
 12-66

MISSISSIPPI
 BOARD OF WATER COMMISSIONERS
 416 North State Street
 Jackson, Mississippi 39201

WATER WELL DRILLERS LOG

Dec. 15 1966 Jumper Well Co Tippah
 date well completed firm name county well located


LANDOWNER:
 Jim Reed
 Tubert, Miss
 (mailing address)

WELL LOCATION:
 sec. 21 T 15 N R 3 E
 S W
 5 miles West of Tubert
 (distance) (direction) (nearest town)

WELL PURPOSE: Home
 (home, irrigation, municipal, industrial)

WELL COMPLETION DATA:
 (1) diameter (inches) 4"
 (2) total depth (feet) 180'
 (3) static water level (feet) 90' below top of ground
 (4) casing PVC, 180'
 (material) (depth)
 4" if telescope see back.
 (size)
 (5) screen 15' 150'
 (length) (depth to top)
 32 PVC + gravel
 (size) (material)
 (6) pump 1 10
 (HP) (yield gpm)
 electric
 (type power)
 (7) electric log NO
 (yes or no)
 (organization running log)
 (8) how well bottom plugged PVC
 cap


description of formations encountered	from to	
sand & rock	0	150
water bearing sand	150	170
blue clay	170	180

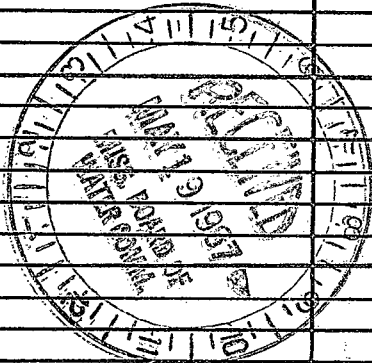

DRILLERS REMARKS:

If well telescopes please sketch and show depths.

GROUND LEVEL

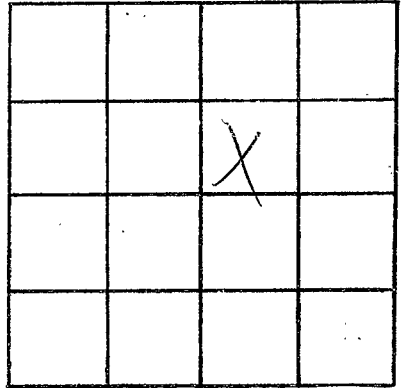

SECTION 21

Please indicate well location X.

ADDITIONAL INFORMATION

If more than one screen, show locations of each on sketch.