


Tippah
 A15
 3-67

MISSISSIPPI
 BOARD OF WATER COMMISSIONERS
 416 North State Street
 Jackson, Mississippi 39201

WATER WELL DRILLERS LOG


March 14 1967 Jumpin Well Co. Tippah
 date well completed firm name county well located

LANDOWNER:	description of fomations encountered	from	to
<u>Bobby Deuse</u> <u>Walnut Miss.</u> (mailing address)			
WELL LOCATION: sec. <u>22</u> T <u>15</u> N R. <u>3</u> E S W	<u>sand and clay</u>	0	140
<u>5</u> miles <u>west</u> of <u>Tubert</u> (distance) (direction) (nearest town)			
WELL PURPOSE: (home, irrigation, municipal, industrial)			
<u>home</u>			
WELL COMPLETION DATA:			
(1) diameter (inches) <u>4</u>			
(2) total depth (feet) <u>180</u>			
(3) static water level (feet) <u>110</u> below above top of ground.			
(4) casing <u>PVC</u> , <u>180</u> (material) (depth)			
<u>4"</u> (size) if telescope see back.			
(5) screen <u>20'</u> , <u>160'</u> (length) (depth to top)			
<u>1/32</u> , <u>pvc + gauze</u> (size) (material)			
(6) pump <u>1</u> <u>?</u> (HP) (yield gpm)			
<u>electricity</u> (type power)			
(7) electric log <u>NO</u> (yes or no)			
<u>NO</u> (organization running log)			
(8) how well bottom plugged <u>none</u>			
DRILLERS REMARKS:			

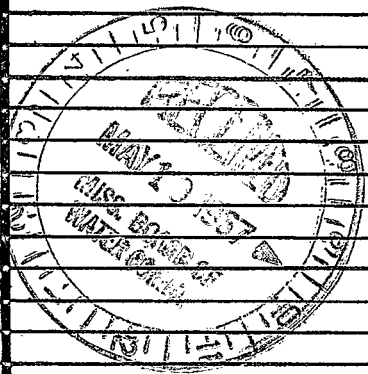

If well telescopes please sketch and show depths.

GROUND LEVEL

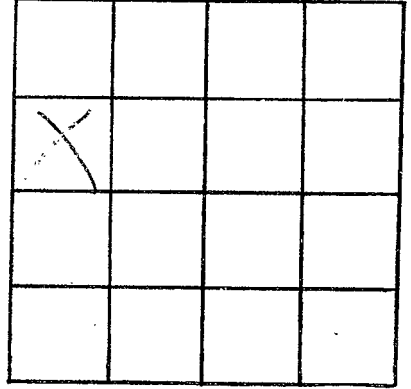

SECTION _____

Please indicate well location X.

ADDITIONAL INFORMATION

If more than one screen,
show locations of each on sketch.