

Jessick  
 A 16  
 2-68

MISSISSIPPI  
 BOARD OF WATER COMMISSIONERS  
 416 North State Street  
 Jackson, Mississippi 39201

WATER WELL DRILLERS LOG

Feb. 5 1968 Jumper Well Co. Jessick  
 date well completed firm name county well located

LANDOWNER: Jimmy Cule  
 Walnut, Miss.  
 (mailing address)

description of formations encountered: mixed sand and clay

from 0 to 70

WELL LOCATION: sec 22 T 1 N R 3 E  
 S W  
 4 miles west of Walnut water  
 (distance) (direction) (nearest town) bearing sand 70 130

WELL PURPOSE: Home  
 (home, irrigation, municipal, industrial)

WELL COMPLETION DATA:

(1) diameter (inches) 4

(2) total depth (feet) 130

(3) static water level (feet) 80 below top of ground.

(4) casing PVC, 130, (material) (depth)  
 If telescope see back. (size)

(5) screen 20, 110 (length) (depth to top)  
 1/32 gravel packed (size) (material)

(6) pump 3/4 10 gal (HP) (yield gpm)  
 electricity (type power)

(7) electric log no (yes or no)  
 yes (organization running log)


(8) how well bottom plugged PVC plug

JUN 26 1968  
 MISS. BOARD OF  
 WATER COMMISSIONERS

DRILLERS REMARKS:

If well telescopes please sketch and show depths.

GROUND LEVEL

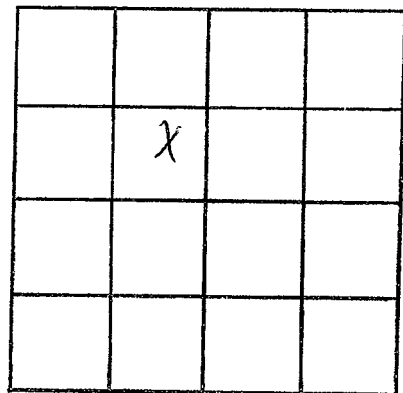

SECTION \_\_\_\_\_

Please indicate well location X.

ADDITIONAL INFORMATION

If more than one screen,  
show locations of each on sketch.