

TIPPAH
A17
2-68

MISSISSIPPI
BOARD OF WATER COMMISSIONERS
416 North State Street
Jackson, Mississippi 39201

WATER WELL DRILLERS LOG

2-23 1968
date well completed

Robert Wilson
firm name

Tippah
county well located

LANDOWNER: Maggie Jones
Walnut

description of formations encountered	from	to
Red sand & red clay	0	10
Red sand	10	60
Red sand & white clay	60	80
White clay	80	120
White sand	120	180

Miss
(mailing address)

WELL LOCATION:
sec. 35 T 1 N R 3 E
5 miles w of Walnut
(distance) (direction) (nearest town)

WELL PURPOSE:
(home, irrigation, municipal, industrial)

WELL COMPLETION DATA:

- (1) diameter (inches) 4
- (2) total depth (feet) 170
- (3) static water level (feet) 80 below top of ground.
- (4) casing plastic 166
(material) (depth)
4 if telescope see back.
(size)
- (5) screen 4', 166
(length) (depth to top)
4, Gravel Pack
(size) (material)
- (6) pump _____ (HP) _____ (yield gpm)
Elect.
(type power)
- (7) electric log _____
(yes or no)

(organization running log)


(8) how well bottom plugged 4"
plastic cap

DRILLERS REMARKS:

MAY 27 1968
MISS. BOARD OF
WATER COMM.

If well telescopes please sketch and show depths.

GROUND LEVEL

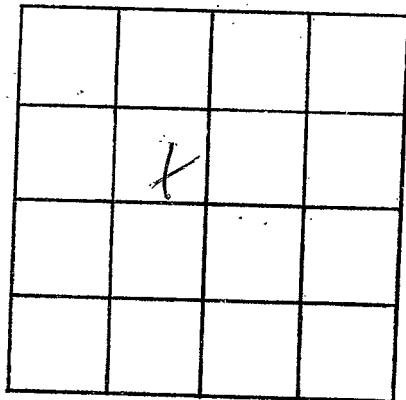

SECTION 35

Please indicate well location X.

ADDITIONAL INFORMATION

If more than one screen,
show locations of each on sketch.