

TIPPAH
A 26
12-18-72

MISSISSIPPI
BOARD OF WATER COMMISSIONERS
416 North State Street
Jackson, Mississippi 39201

600 00
30 00
630 00
CODED

WATER WELL DRILLERS LOG

12 18 19 72 date well completed
J T Meeker firm name
Tippah county well located

LANDOWNER:
Father & Parkner
Walnut
(mailing address)

description of formations encountered
red clay
red sand
from 0
to 80

WELL LOCATION:
sec. 20 T. 1 N. R. 3 E
6 miles W of Walnut
(distance) (direction) (nearest town)

WELL PURPOSE:
(home, irrigation, municipal, industrial)

WELL COMPLETION DATA:
(1) diameter (inches) 4
(2) total depth (feet) 80
(3) static water level (feet) 60 below top of ground.
(4) casing P 80 (material) (depth)
(size) if telescope see back.
(5) screen 10 80 (length) (depth to top)
(size) (material)
(6) pump 3/4 5 (HP) (yield gpm)
(type power)
(7) electric log (yes or no)
(organization running log)
(8) how well bottom plugged

CODED


FEB 5 1973

DRILLERS REMARKS:

MISS. BD. OF
WATER COMM

If well telescopes please
sketch and show depths.

GROUND LEVEL

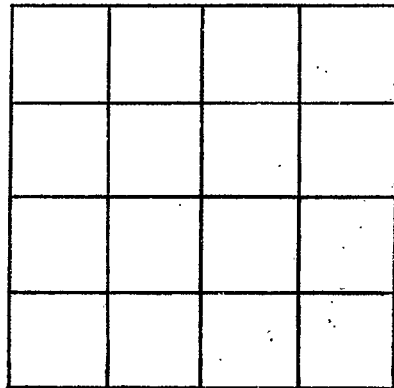

SECTION _____

Please indicate well location X.

ADDITIONAL INFORMATION

If more than one screen,
show locations of each on sketch.