

A 27
 TIPPAH
 4-10-73

MISSISSIPPI
 BOARD OF WATER COMMISSIONERS
 416 North State Street
 Jackson, Mississippi 39201

CODED

WATER WELL DRILLERS LOG

April 10 19 73 Robert W. Wilson Tippah
 date well completed firm name county well located

LANDOWNER: <u>L. W. Castel</u>	description of formations encountered	from	to
<u>Walnuts, Miss</u>			
	<u>red sand</u>	<u>30</u>	<u>52</u>

(mailing address)

WELL LOCATION:

sec. 20T 1 N 3 E
S W
 miles _____ of _____
 (distance) (direction) (nearest town)

WELL PURPOSE:

(home, irrigation, municipal, industrial)

WELL COMPLETION DATA:

- (1) diameter (inches) 4
- (2) total depth (feet) 55
- (3) static water level (feet) 0 below above top of ground.
- (4) casing Plastic 5.5, (material) (depth)
 _____ if telescope see back. (size)
- (5) screen 8, 47 (length) (depth to top)
4, gravel packed (size) (material)
- (6) pump 3/4, 10 (HP) (yield gpm)
electric (type power)
- (7) electric log _____ (yes or no)
 _____ (organization running log)
- (8) how well bottom plugged 4"
plastic cap


CODED

DRILLERS REMARKS:

AUG 28 1973

If well telescopes please sketch and show depths.

GROUND LEVEL

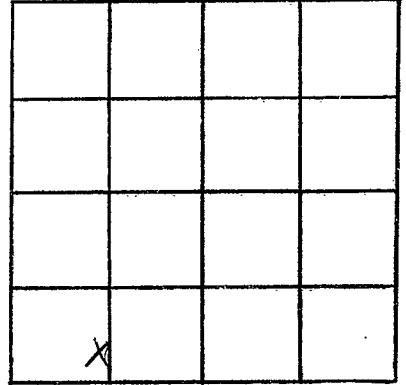

SECTION 20

Please indicate well location X.

ADDITIONAL INFORMATION

If more than one screen,
show locations of each on sketch.