

122

A 28  
TIPPAH  
7-23-73

MISSISSIPPI  
BOARD OF WATER COMMISSIONERS  
416 North State Street  
Jackson, Mississippi 39201

**CODED**

WATER WELL DRILLERS LOG

7-23 19 73 Robert W. Wilborn Tippan  
date well completed firm name county well located

LANDOWNER: J. L. Dallar

description of formations encountered from to

Wabants, Miss.

red. clay, red sand, 0 30  
red sand, 30 65

(mailing address)

white clay, white sand, 65 90  
white sand 90 125

WELL LOCATION:

sec. 27 T-1 N R-3 E  
S W

miles of  
(distance) (direction) (nearest town)

WELL PURPOSE:

(home, irrigation, municipal, industrial)

WELL COMPLETION DATA:

- (1) diameter (inches) 4
- (2) total depth (feet) 130
- (3) static water level (feet) 90 below top of ground.
- (4) casing Plastic, 126,  
(material) (depth)

**CODED**

\_\_\_\_\_ if telescope see back.  
(size)

- (5) screen 4, 130  
(length) (depth to top)

\_\_\_\_\_ gravel packed  
(size) (material)

- (6) pump 3/4, 10  
(HP) (yield gpm)

electric  
(type power)

- (7) electric log \_\_\_\_\_  
(yes or no)

\_\_\_\_\_ (organization running log)


- (8) how well bottom plugged 4"  
plastic cap

DRILLERS REMARKS:

AUG 23 1973

If well telescopes please sketch and show depths.

GROUND LEVEL

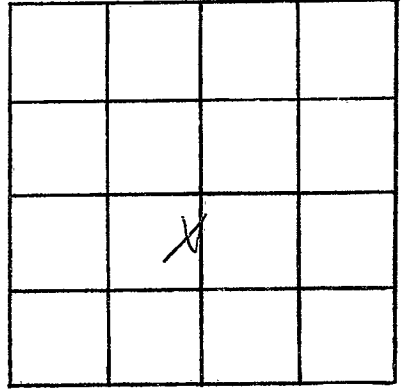

SECTION 27

Please indicate well location X.

ADDITIONAL INFORMATION

If more than one screen,  
show locations of each on sketch.