

TIPPAH
A 29
9-25-73

MISSISSIPPI
BOARD OF WATER COMMISSIONERS
416 North State Street
Jackson, Mississippi 39201

CODED

WATER WELL DRILLERS LOG

9-25 1973 *Plant that Surveys* firm name *Tippha* county well located


LANDOWNER:	description of formations encountered	from	to
<i>Nattie F. Campbell</i>			
<i>Walnut Miss.</i> (mailing address)	<i>Sand</i>	<i>10</i>	<i>60</i>

WELL LOCATION:	description of formations encountered	from	to
sec. <i>33</i> T <i>1</i> N <i>3</i> R <i>2</i> E ? <i>5</i> miles <i>west</i> of <i>Walnut</i> (distance) (direction) (nearest town)			
	<i>Sand</i>	<i>65</i>	<i>140</i>

WELL PURPOSE: *Drillers*
(home, irrigation, municipal, industrial)

- WELL COMPLETION DATA:
- (1) diameter (inches) *4"*
 - (2) total depth (feet) *140 feet*
 - (3) static water level (feet) *20* below above top of ground.
 - (4) casing *PVC* (material) *140 feet* (depth)
 - (size) If telescope see back.
 - (5) screen *7 ft.* (length) *133 feet* (depth to top)
 - 4"* (size) *gravel wall* (material)
 - (6) pump *3/4* (HP) *14* (yield gpm)
 - (type power)
 - (7) electric log *Elect.* (yes or no)
 - (organization running log)
 - (8) how well bottom plugged *4" cap.*

CODED

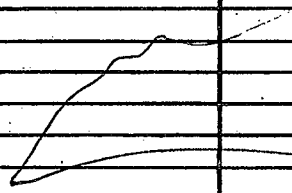


DRILLERS REMARKS:

OCT 9 1973

If well telescopes please sketch and show depths.

GROUND LEVEL

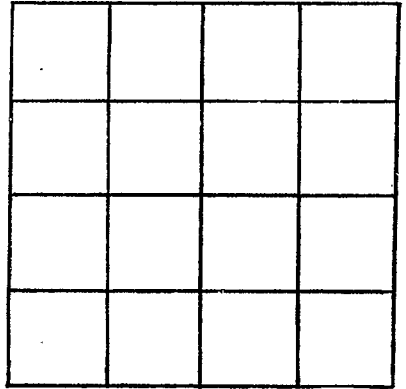

SECTION _____

Please indicate well location X.

ADDITIONAL INFORMATION

If more than one screen, show locations of each on sketch.