

TIPPAN
A 30
10-17-73

MISSISSIPPI
BOARD OF WATER COMMISSIONERS
416 North State Street
Jackson, Mississippi 39201

CODED

WATER WELL DRILLERS LOG

10-17-1973 date well completed Robert W. Wilson firm name Tippah county well located

LANDOWNER: J.C. Michael
Walnut, Miss.
(mailing address)

description of formations encountered	from	to
red clay, red sand, white clay	0	30
blue clay	30	120
blue clay, rock	120	135
blue clay	135	265
rock	265	284
blue clay	284	300
blue clay	300	310
green sand	310	350

WELL LOCATION:
sec. 24 T1 N R 30 E
S W
_____ miles _____ of _____
(distance) (direction) (nearest town)

WELL PURPOSE:
(home, irrigation, municipal, industrial)

WELL COMPLETION DATA:

(1) diameter (inches) 4

(2) total depth (feet) 350

(3) static water level (feet) 90 below above top of ground.

(4) casing _____, _____
(material) (depth)
_____ if telescope see back.
(size)

(5) screen 10, 340
(length) (depth to top)
4, gravel packed
(size) (material)

(6) pump 1, 15
(HP) (yield gpm)
electric
(type power)

(7) electric log _____
(yes or no)

(organization running log)

(8) how well bottom plugged 24"
plastic cap

CODED


FEB 19 1974

DRILLERS REMARKS:

Miss. Bd. OF WATER COMMISSIONERS

If well telescopes please sketch and show depths.

GROUND LEVEL

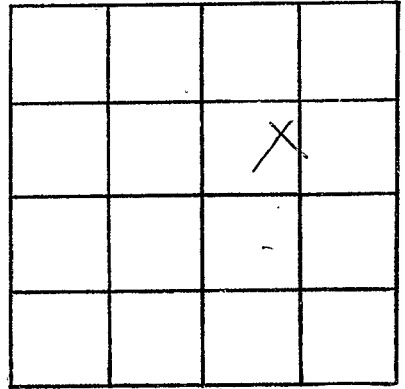

SECTION 24

Please indicate well location X.

ADDITIONAL INFORMATION

Lined area for additional information.

If more than one screen, show locations of each on sketch.