

TIPPAH
A 31
3-24-75

MISSISSIPPI
BOARD OF WATER COMMISSIONERS
416 North State Street
Jackson, Mississippi 39201

WATER WELL DRILLERS LOG

CODED

3 24 19 75 date well completed
J T Hedden firm name
Tippan county well located

LANDOWNER: Jess Smith
Walnut
(mailing address)

description of formations encountered	from	to
<u>Clay</u>	<u>0</u>	<u>8</u>
<u>Sand</u>	<u>8</u>	<u>90</u>
<u>Clay</u>	<u>90</u>	<u>97</u>

WELL LOCATION:
sec 32 T 1 N R 3 E
6 miles W of Walnut
(distance) (direction) (nearest town)

WELL PURPOSE:
(home, irrigation, municipal, industrial)

WELL COMPLETION DATA:

(1) diameter (inches) 4

(2) total depth (feet) 97

(3) static water level (feet) 70 below above top of ground.

(4) casing P 80
(material) (depth)
(size) if telescope see back.

(5) screen 10 70
(length) (depth to top)
4 P
(size) (material)

(6) pump 3/4 14
(HP) (yield gpm)
E
(type power)

(7) electric log _____
(yes or no)

(organization running log)

(8) how well bottom plugged any

DRILLERS REMARKS:


CODED

RECEIVED

APR 18 1975

If well telescopes please
sketch and show depths.

GROUND LEVEL

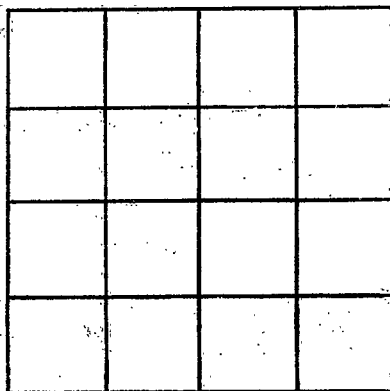

SECTION _____

Please indicate well location X.

ADDITIONAL INFORMATION

If more than one screen,
show locations of each on sketch.