

A 32  
 Lumbah  
 4/9/75

MISSISSIPPI  
 BOARD OF WATER COMMISSIONERS  
 416 North State Street  
 Jackson, Mississippi 39201

CODED

WATER WELL DRILLERS LOG

49 19 25 J T M Lumbah  
 date well completed firm name county well located

LANDOWNER: W. L. Finney  
 Hwy 22 W. Walnut  
 (mailing address)

description of formations encountered	from	to
Clay	0	16
sand & clay	16	180
loose clay	180	260
rock & sand	260	320

WELL LOCATION:  
 sec. 35 T 1 N R 3 E  
 3 miles W of Walnut  
 (distance) (direction) (nearest town)

WELL PURPOSE:  
 (home, irrigation, municipal, industrial)

WELL COMPLETION DATA:

(1) diameter (inches) 4

(2) total depth (feet) 380

(3) static water level (feet) 120 below top of ground.

(4) casing P 180 (material) (depth)

(size) If telescope see back.

(5) screen (length) (depth to top)

(size) (material)

(6) pump 1/2 7 (HP) (yield gpm)

(type power)

(7) electric log (yes or no)

(organization running log)

(8) how well bottom plugged


CODED

RECEIVED  
 MAY 27 1975

DRILLERS REMARKS:

If well telescopes please sketch and show depths.

GROUND LEVEL

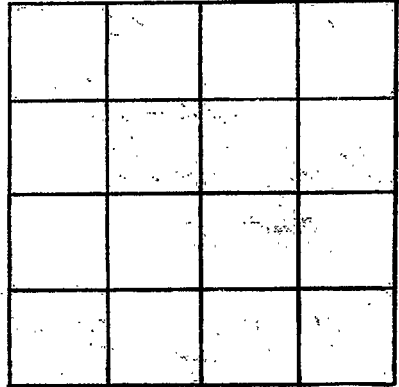

SECTION \_\_\_\_\_

Please indicate well location X.

ADDITIONAL INFORMATION

If more than one screen, show locations of each on sketch.