

Lippah
A 33
6-30-75

MISSISSIPPI
BOARD OF WATER COMMISSIONERS
416 North State Street
Jackson, Mississippi 39201

WATER WELL DRILLERS LOGGED

10/20/75
10/20/75
10/20/75
10/20/75

6 30 1975 T. Madson Lippah
date well completed firm name county well located

LANDOWNER: Ketton, Motton
R. I. Walnut

(mailing address)

WELL LOCATION:
sec 35 T 1 N R 3 E 16L
4 miles W of Walnut
(distance) (direction) (nearest town)

description of formations encountered		from	to
Red clay		0	12
Siltstone		12	265
Sand & gravel		265	365

WELL PURPOSE:
(home, irrigation, municipal, industrial)

- WELL COMPLETION DATA:
- (1) diameter (inches) 4
 - (2) total depth (feet) 360
 - (3) static water level (feet) 126 below top of ground
 - (4) casing (material) P (depth) 210
if telescope see back.
(size) _____
 - (5) screen (length) _____ (depth to top) _____
(size) _____ (material) _____
 - (6) pump 2 (HP) 6 (yield gpm)
E
(type power)
 - (7) electric log _____ (yes or no)
(organization running log)
 - (8) how well bottom plugged _____


CODED

DRILLERS REMARKS:
JUL - 9 1975

DRILLERS REMARKS:

If well telescopes please sketch and show depths.

GROUND LEVEL

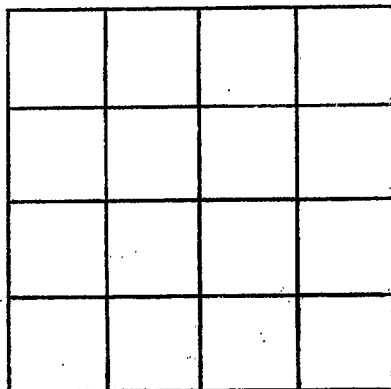

SECTION _____

Please indicate well location X.

ADDITIONAL INFORMATION

If more than one screen, show locations of each on sketch.