

TIPPAN  
A 2000  
1-3-76

MISSISSIPPI  
BOARD OF WATER COMMISSIONERS  
416 North State Street  
Jackson, Mississippi 39201

WATER WELL DRILLERS LOG

1-3-76 <sup>16L</sup> 1976 J. T. Martin Tippah  
date well completed firm name county well located

LANDOWNER: James R. ... Walnut MS  
(mailing address)  
WELL LOCATION: 3 mi miles N.W. (direction) of Walnut (nearest town)  
sec. 26 T 1 N 3 E W

description of formations encountered	from	to
<u>mucl + sand</u>	<u>0</u>	<u>100</u>
<u>rock + sand</u>	<u>100</u>	<u>160</u>
<u>sand + gravel</u>	<u>160</u>	<u>170</u>

WELL PURPOSE: ...  
(home, irrigation, municipal, industrial)

WELL COMPLETION DATA:  
(1) diameter (inches) 4 inch  
(2) total depth (feet) 170  
(3) static water level (feet) 120 below above top of ground.  
(4) casing mucl 160 (material) (depth)  
\_\_\_\_\_ if telescope see back. (size)  
(5) screen \_\_\_\_\_ (length) (depth to top)  
\_\_\_\_\_ (size) \_\_\_\_\_ (material)  
(6) pump Electric (HP) \_\_\_\_\_ (yield gpm)  
(type power)  
(7) electric log \_\_\_\_\_ (yes or no)  
\_\_\_\_\_ (organization running log)

DRILLERS REMARKS:


RECEIVED

FEB 2 1976

MISS. BD. OF WATER COMMISSIONERS

If well telescopes please  
sketch and show depths.

GROUND LEVEL

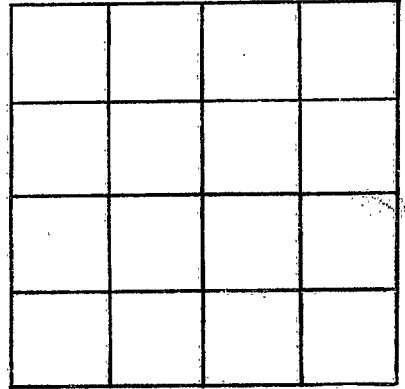

SECTION \_\_\_\_\_

Please indicate well location X.

ADDITIONAL INFORMATION

If more than one screen,  
show locations of each on sketch.