

Tippah
A 2003
7-10-76

MISSISSIPPI
BOARD OF WATER COMMISSIONERS
416 North State Street
Jackson, Mississippi 39201

WATER WELL DRILLERS LOG

7/10/76 19 *16L* Melvin Well Drilling Tippah
date well completed firm name county well located

Need Section

LANDOWNER: Wayne Smith
Wayne Smith
Walnut Miss
(mailing address)

description of formations encountered	from	to
	<u>Shale & Rock</u>	<u>0</u>
<u>Sand & Rock</u>	<u>60</u>	<u>125</u>

WELL LOCATION:
sec. 4 T. 1 N. R. 30
West of Brownville
(distance) miles (direction) of (nearest town)

WELL PURPOSE: Home
(home, irrigation, municipal, industrial)

WELL COMPLETION DATA:
(1) diameter (inches) 4
(2) total depth (feet) 125
(3) static water level (feet) 70 below above top of ground.
(4) casing Plastic 125
(material) (depth)
(size) If telescope see back.
(5) screen 10 115
(length) (depth to top)
4 Plastic
(size) (material)
(6) pump 1/2 11
(HP) (yield gpm)
(type power)
(7) electric log yes or no
(organization running log)
(8) how well bottom plugged 10


RECEIVED

DEC 2 1976

DRILLERS REMARKS:

If well telescopes please sketch and show depths.

GROUND LEVEL

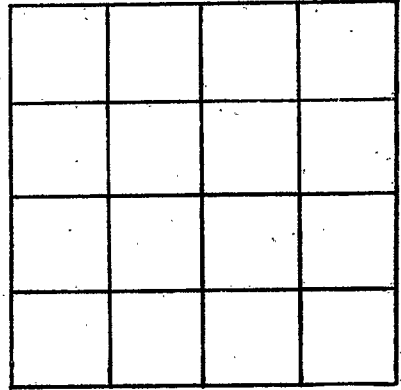

SECTION _____

Please indicate well location X.

ADDITIONAL INFORMATION

If more than one screen, show locations of each on sketch.