

Tippah
B.A. 2001
6-25-79

MISSISSIPPI
 BOARD OF WATER COMMISSIONERS
 416 North State Street
 Jackson, Mississippi 39201

*location in
Tippah*

WATER WELL DRILLERS LOG

Tippah
Bepton

6-25-79 date well completed Robert Wilson firm name county well located

LANDOWNER:	description of formations encountered	from	to
<u>Roberts Day</u> <u>1428 Weymouth Memphis, In.</u> (mailing address)	<u>Red clay Red Sand</u> <u>White clay + white Sand</u>	<u>0</u> <u>30</u>	<u>30</u> <u>57</u>
WELL LOCATION: sec. <u>21</u> T <u>1</u> N <u>S</u> R <u>3</u> E <u>W</u> (distance) miles (direction) of (nearest town)			
WELL PURPOSE: (home, irrigation, municipal, industrial)			
WELL COMPLETION DATA:			
(1) diameter (inches) <u>4</u>			
(2) total depth (feet) <u>57</u>			
(3) static water level (feet) <u>20</u> below above top of ground.			
(4) casing (material) <u>4 1/2</u> (depth) <u>4</u> if telescope see back. (size)			
(5) screen <u>10</u> (length) (depth to top)			
<u>4</u> (size) <u>gravel</u> (material)			
(6) pump <u>3/4</u> (HP) <u>10</u> (yield gpm)			
<u>electric</u> (type power)			
(7) electric log (yes or no)			
(organization running log)			
(8) how well bottom plugged <u>4"</u>			
DRILLERS REMARKS: <u>Plastic Cap</u>			


Miss. Board of Water Comm

JUL 10 1979

RECEIVED

If well telescopes please sketch and show depths.

GROUND LEVEL

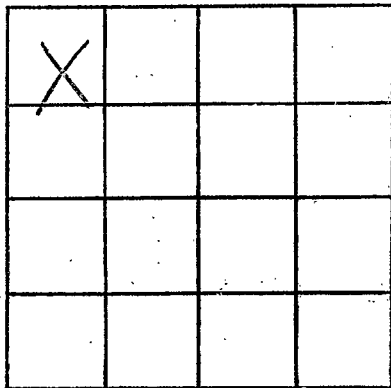

SECTION 21

Please indicate well location X.

ADDITIONAL INFORMATION

If more than one screen, show locations of each on sketch.