

TIPPAH

MISSISSIPPI  
BOARD OF WATER COMMISSIONERS  
416 North State Street  
Jackson, Mississippi 39201

A 2012  
5-26-80

WATER WELL DRILLERS LOG

5-26 1980  
date well completed

Robert W. Williams  
firm name

Tippah  
county well located

LANDOWNER:

Mr. Margaret Chaney  
Rt# Box 194A Grand Junction  
(mailing address)

description of formations  
encountered

from

to

Red Clay + Red Sand	0	30
Red Sand	30	60
Red sand + white clay	60	90
white sand	90	120

WELL LOCATION:

sec. 4 T. 1 N. R. 3E  
miles of (distance) (direction) (nearest town)

WELL PURPOSE:

(home, irrigation, municipal, industrial)

WELL COMPLETION DATA:

- (1) diameter (inches) 4
- (2) total depth (feet) 120
- (3) static water level (feet) 60 below top of ground.
- (4) casing PVC (material) 120 (depth)
- (size) If telescope see back.
- (5) screen 10 (length) 110 (depth to top)
- (size) (material)
- (6) pump 3/4 (HP) 10 (yield gpm)
- (type power)
- (7) electric log (yes or no)

(organization running log)

(8) how well bottom plugged 4"

DRILLERS REMARKS:


DEPT. OF NATURAL RESOURCES  
BUREAU OF LAND & WATER RESOURCES

JUN 30 1980

RECEIVED

If well telescopes please sketch and show depths.

GROUND LEVEL

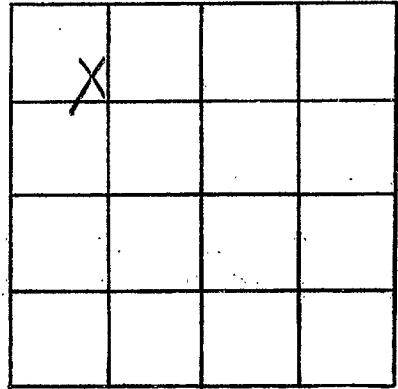

SECTION 21

Please indicate well location X.

ADDITIONAL INFORMATION

If more than one screen, show locations of each on sketch.