

**MISSISSIPPI
BOARD OF WATER COMMISSIONERS**
416 North State Street
Jackson, Mississippi 39201

WATER WELL DRILLERS LOG

TIPDAH
A 2013
11-2-80

11-2-80 19 Wilson Well Co. Dupala
date well completed firm name county well located


LANDOWNER:	description of formations encountered	from	to
<u>Annie B. Casley</u>			
<u>Pl 3 Box 33 Walnut, Miss</u> (mailing address)	<u>Red clay, red sand</u>	<u>0</u>	<u>30</u>
	<u>Red Sand</u>	<u>30</u>	<u>90</u>
	<u>White Clay, white sand</u>	<u>90</u>	<u>105</u>
	<u>white sand</u>	<u>105</u>	<u>150</u>
WELL LOCATION:			
sec. <u>31</u> T. <u>1</u> N. R. <u>3</u> E <u>2</u> miles <u>E</u> of <u>Arp</u> (nearest town)			
WELL PURPOSE: (home, irrigation, municipal, industrial)			
WELL COMPLETION DATA:			
(1) diameter (inches) <u>4</u>			
(2) total depth (feet) <u>145</u>			
(3) static water level (feet) _____ below/above top of ground.			
(4) casing <u>Plastic</u> , <u>125</u> (material) (depth) <u>4"</u> if telescope see back. (size)			
(5) screen <u>10</u> , <u>135</u> (length) (depth to top) <u>4</u> , <u>gravel packed</u> (size) (material)			
(6) pump <u>3/4</u> , <u>10</u> (HP) (yield gpm) <u>electric</u> (type power)			
(7) electric log <u>No</u> (yes or no) (organization running log)			
(8) how well bottom plugged <u>plastic cap</u>			
DRILLERS REMARKS:			

DEPT. OF NATURAL RESOURCES
BUREAU OF LAND & WATER RESOURCES

DEC 18 1980
RECEIVED

If well telescopes please sketch and show depths.

GROUND LEVEL

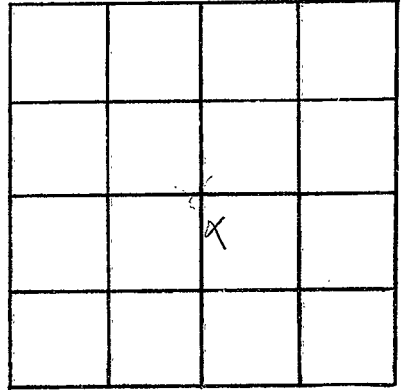

SECTION 31

Please indicate well location X.

ADDITIONAL INFORMATION

If more than one screen,
show locations of each on sketch.