

MISSISSIPPI DEPARTMENT OF NATURAL RESOURCES

Bureau of Land and Water Resources

Southport Mall

P.O. Box 10631

Jackson, Mississippi 39209

WATER WELL DRILLERS LOG

Tippecanoe
A
2014

5-13-82
 date well completed

Wilson Well Co
 firm name

Tippecanoe
 county well located

| LANDOWNER: | description of formations encountered | from | to |
|---|---|---|---|
| <p><u>David Tidwell</u> <u>Rt 1, Box 5-22</u> <u>Walnut, MS 38683</u> (mailing address)</p> | <p><u>Red clay-white clay</u> <u>White sand</u> <u>White sand</u></p> | <p><u>0</u> <u>30</u> <u>30</u></p> | <p><u>30</u> <u>—</u> <u>50</u></p> |
| <p>WELL LOCATION: sec <u>29</u> T <u>1</u> N R <u>3</u> E <u>6</u> miles (distance) of <u>Walnut</u> (nearest town)</p> | | | |
| <p>WELL PURPOSE: <u>home</u> (home, irrigation, municipal, industrial)</p> | | | |
| <p>WELL COMPLETION DATA:</p> | | | |
| <p>(1) diameter (inches) <u>4</u></p> | | | |
| <p>(2) total depth (feet) <u>50</u></p> | | | |
| <p>(3) static water level (feet) <u>—</u> below / above top of ground.</p> | | | |
| <p>(4) casing <u>Plastic</u> (material) (depth) <u>4</u> if telescope see back. (size)</p> | | | |
| <p>(5) screen <u>10</u> (length) (depth to top) <u>4</u> (size) <u>Plastic</u> (material)</p> | | | |
| <p>(6) pump <u>none</u> (HP) (yield gpm) <u>—</u></p> | | | |
| <p>(type power) <u>—</u></p> | | | |
| <p>(7) electric log <u>—</u> (yes or no)</p> | | | |
| <p>(organization running log) <u>—</u></p> | | | |
| <p>(8) how well bottom plugged <u>4" Plastic cap</u></p> | | | |
| <p>DRILLERS REMARKS: <u>—</u></p> | | | |


DEPT. OF NATURAL RESOURCES
 BUREAU OF LAND & WATER RESOURCES

JUL 21 1982

RECEIVED

If well telescopes please sketch and show depths.

GROUND LEVEL

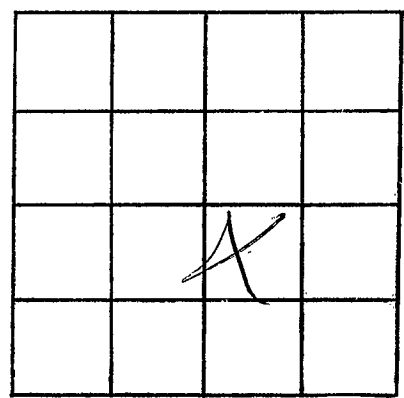

SECTION 29

Please indicate well location X.

ADDITIONAL INFORMATION

A series of horizontal lines for writing additional information.

If more than one screen, show locations of each on sketch.