

MISSISSIPPI DEPARTMENT OF NATURAL RESOURCES
Bureau of Land and Water Resources
 Southport Mall
 P.O. Box 10631
 Jackson, Mississippi 39209
WATER WELL DRILLERS LOG

Tippah
A
2010

Oct. 10 1983 Wilson well Co. Inc. Tippah
 date well completed firm name county well located

LANDOWNER: Harvey Bennetfield
1209 Pera
Memphis Tn - 38127
 (mailing address)

WELL LOCATION:
 sec 26 T 1 N R 3 E
5 miles W of walnut
 (distance) (direction) (nearest town)

WELL PURPOSE: Home
 (home, irrigation, municipal, industrial)

WELL COMPLETION DATA:
 (1) diameter (inches) 4
 (2) total depth (feet) 380
 (3) static water level (feet) 90 below above top of ground.
 (4) casing Plastic, 380,
 (material) (depth)
4 if telescope see back.
 (size)
 (5) screen 20, 380
 (length) (depth to top)
4, Plastic
 (size) (material)
 (6) pump 3/4, 9
 (HP) (yield gpm)
Electric
 (type power)
 (7) electric log No
 (yes or no)

(organization running log)

(8) how well bottom plugged 4-PVC
CAP

description of formations encountered	from	to
Brown Sand	0	12
Blue CLAY	12	115
ROCK	115	118
Blue CLAY	118	124
ROCK	124	131
Blue CLAY	131	223
ROCK	223	228
Blue CLAY	228	317
ROCK	317	319
lignite	319	325
ROCK	325	337
GRAY SAND	337	339
ROCK	339	352
Brown Sand	352	380

DEPT. OF NATURAL RESOURCES
 BUREAU OF LAND & WATER RESOURCES


DEC 19 1983

RECEIVED

DRILLERS REMARKS:

If well telescopes please sketch and show depths.

GROUND LEVEL

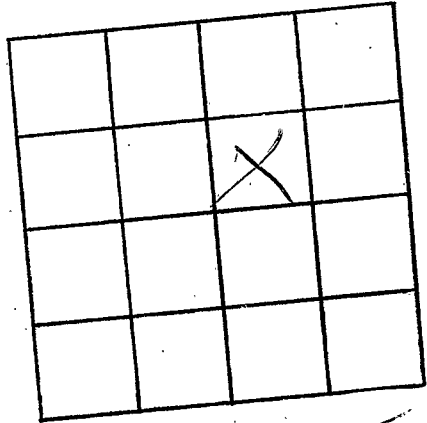

SECTION 28

Please indicate well location X.

ADDITIONAL INFORMATION

If more than one screen, show locations of each on sketch.