

MISSISSIPPI DEPARTMENT OF ENVIRONMENTAL QUALITY

Office of Land and Water Resources

P. O. Box 10631  
Jackson, MS 39289-0631  
WATER WELL DRILLERS LOG

COUNTY WELL LOCATED  
*Tippah*

WELL NUMBER  
*15 of A 2024*

CODED  
*1997 year*

PERMIT NUMBER

NAME OF DRILLING FIRM  
*Medlin Well*

DATE WELL COMPLETED  
*5-13-97*

*Blue Mtn MS*

PERMIT NUMBER

NAME OF DRILLING FIRM  
*Medlin Well*

*Blue Mtn MS*

NAME & MAILING ADDRESS OF LANDOWNER  
*Patrick Mehib Home*  
*Corinth MS*  
*% Steve Taylor*

WELL LOCATION: SEC *14* TOWNSHIP *1* RANGE *3* *(E)*

DISTANCE *4* MILES DIRECTION *W* NEAREST TOWN *Brownfield*

OTHER LANDMARK  
*Tomson St Lin*

WELL PURPOSE:  Irrigation,  Municipal,  Industrial,  Fish Pond, etc.

PUMP DATA

PUMP TYPE (Circle One):  
 Submersible, Turbine, Jet, Flowing Well,  
Other (Describe) \_\_\_\_\_

POWER TYPE (Circle One):  
 Electric, Tractor, Diesel, Gasoline, Butane,  
Other (Describe) \_\_\_\_\_ H/P \_\_\_\_\_

Pump Capacity (GPM) *12* No. of Stages *12* Setting Depth *200* FT.

PUMP TEST  
Well yielded *12* GPM with  
a drawdown of *8* ft.  
after *6* hours of pumping

WELL DATA

Well Depth *480* Casing Diameter (In.) *4"* Casing Length (Ft.) *450*

Type of Casing *PVC* Hole Depth *480* Depth to Static Water Level *160"*

TYPE OF COMPLETION: (Circle One or More):  
 Gravel Packed,  Underreamed,  Telescoped,  
 Natural Development,  Open Hole,  Other

WELL GROUTED TO A DEPTH OF *10* FEET  
Type Grout (circle one): Cement, Bentonite, or Mix

LOG DATA

TYPE OF LOG RUN (Circle One):  
 No Log Run,  
Electric, Gamma Ray, Density, Sonic, Neutron,  
Other (Describe) \_\_\_\_\_

Name of Organization Running Log \_\_\_\_\_

SCREEN DATA

Diameter (Inches) *4* Length - Feet *30'* Slot Size - Inches *00.13*

Screen Type *PVC* Depth to Bottom - Feet *450-480*

GEOLOGIC DATA (Office Use Only)

Surface Elev.	Geologic Unit	Unit Thickness	Depth to Top
Subs. SWL	Date	Water Test	

Driller's Remark **RECEIVED**

DEC 11 1997

Top of Lap Pipe or Reduction in Casing


DATE OF  IF TELESCOPED OR MORE THAN ONE CORE ENTER ON SE BACK PAGE

DESCRIPTION OF FORMATIONS ENCOUNTERED	FROM	TO	FORMATIONS (Continued)	FROM	TO
<i>Rock sand.</i>	<i>0</i>	<i>120</i>	<i>grey clay,</i>	<i>250</i>	<i>380</i>
<i>white clay</i>			<i>Shell Rock</i>		
<i>sand stone</i>	<i>120</i>	<i>250</i>	<i>Rock</i>	<i>380</i>	<i>480</i>
<i>Blue, white clay</i>			<i>Aquifer</i>		

IF MORE SPACE IS NEEDED, USE BACK

If well telescopes please sketch and show depths.

GROUND LEVEL

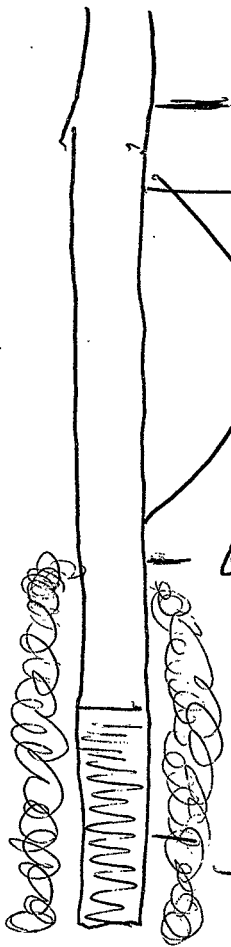


10'

Concrete

4" PVC casing

400 to 480 gravel packed

30' 4" Screen

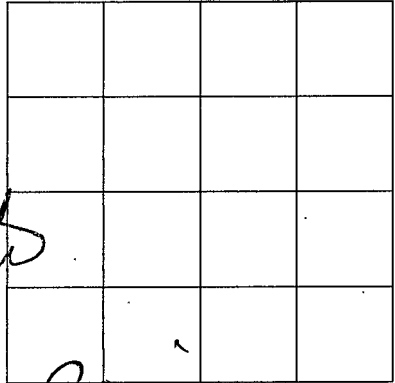

SECTION

Please indicate well location X.

ADDITIONAL INFORMATION

If more than one screen, show location of each on sketch.