

TIPPAH
 B 13
 11-11-70

MISSISSIPPI
 BOARD OF WATER COMMISSIONERS
 416 North State Street
 Jackson, Mississippi 39201

CODED

WATER WELL DRILLERS LOG

11-11-70 date well completed J.T. Mullins firm name Tippah county well located

LANDOWNER: Jane Hodum
Walnut Miss
 (mailing address)

description of formations encountered	from	to
	Red Clay	0
Loam	18	23
Shale	23	170
Sand	170	230

WELL LOCATION:
 sec. 29 T. 1 N. 4 E.
3 miles N of Walnut
 (distance) (direction) (nearest town)

WELL PURPOSE:
 (home, irrigation, municipal, industrial)

- WELL COMPLETION DATA:
- (1) diameter (inches) 4
 - (2) total depth (feet) 23
 - (3) static water level (feet) 110 below above top of ground.
 - (4) casing P 80
 (material) (depth)
 (size) if telescope see back.
 - (5) screen _____
 (length) (depth to top)
 (size) (material)
 - (6) pump 2 6
 (HP) (yield gpm)
C
 (type power)
 - (7) electric log _____
 (yes or no)
 (organization running log)
 - (8) how well bottom plugged _____

CODED

DEC 3 1970


DRILLERS REMARKS:

MISS. BD. OF
 WATER COMM.

If well telescopes please sketch and show depths.

~~GROUND LEVEL~~

18 0
 25 18
 15 35
 0 150
 2 150

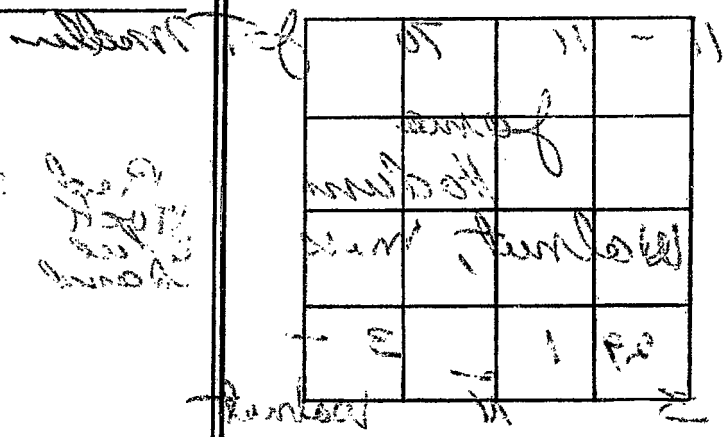

SECTION 1

Please indicate well location X.

ADDITIONAL INFORMATION

10
 25
 110
 200 D

10
 10
 10

If more than one screen, show locations of each on sketch.