

TIPPAH
B14
4-20-71

MISSISSIPPI
BOARD OF WATER COMMISSIONERS
416 North State Street
Jackson, Mississippi 39201

CODED

WATER WELL DRILLERS LOG

4-20 19 71 J.T. Mellin Tippah
date well completed firm name county well located

LANDOWNER: Earlin Starnes
Texas
~~Walnut~~ walnut
H.W. 72 W (mailing address)
WELL LOCATION:
sec. 16 T. 1 N. R. 4 E
2 miles W of walnut
(distance) (direction) (nearest town)

description of formations encountered	from	to
<u>Clay</u>	<u>0</u>	<u>19</u>
<u>Blue</u>	<u>19</u>	<u>75</u>
<u>Sand</u>	<u>75</u>	<u>112</u>
<u>Blue</u>	<u>112</u>	<u>160</u>
<u>Sand + Rock</u>	<u>160</u>	<u>230</u>

WELL PURPOSE:
(home, irrigation, municipal, industrial)

WELL COMPLETION DATA:
(1) diameter (inches) 4
(2) total depth (feet) 230
(3) static water level (feet) 100 below above top of ground.
(4) casing P 160
(material) (depth)
(size) if telescope see back.
(5) screen _____
(length) (depth to top)
(size) 1/2 (material) 8
(6) pump _____
(HP) (yield gpm)
E
(type power)
(7) electric log _____
(yes or no)
(organization running log)
(8) how well bottom plugged BW


CODED

MAY 4 1971

DRILLERS REMARKS:

If well telescopes please sketch and show depths.

GROUND LEVEL

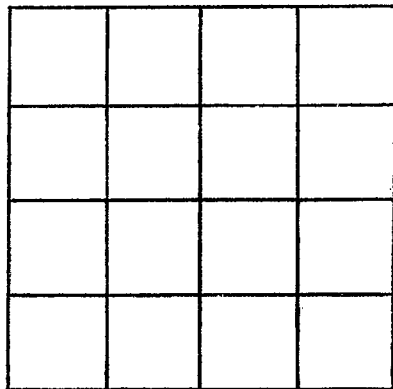

SECTION _____

Please indicate well location X.

ADDITIONAL INFORMATION

If more than one screen, show locations of each on sketch.