

TIPPAH  
B15

WATER WELL DRILLERS LOG

Can't locate  
**CODED**

7-21-60

Date: 7-21, 1960, Driller: Ed Melliss County Tippah  
(Name)

**GAMBURN**

(1) Owner of Land: H.W. Gantman  
(Name)

Description & Color of Materials  
Sand, Clay, Red Clay, Shell, etc.

Thick-  
ness  
Feet

Depth  
Feet

Brownville, Miss.  
(Address)

Red Clay

4'

(2) Location: 1/4, 16 15 4E, Sec. 16 15 4E, T. R.

Red Sand

20'

1/2 miles East, of Brownville  
(distance) (direction) (Nearest Town)

White Mud

3d

(3) Topography: Level  
(Hilly) (Flat) (Level)

Blue Mud

240'

(4) Purpose of Well: Domestic  
(Domestic Irrigation  
Municipal, Industrial, Other)

Deep Rock white  
sand, Blue Sand,  
& Gray Sand

130'

Information upon completion of well:

(1) Diameter 4 inches.


(2) Total Depth 224 feet.

(3) Water Level 40 feet below top of ground.

(4) Cased to Blue Mud, Size 4"

(5) Screen: Size \_\_\_\_\_, Length \_\_\_\_\_.

(6) Were any formations sealed against pollution?  
\_\_\_\_\_ yes, \_\_\_\_\_ no.

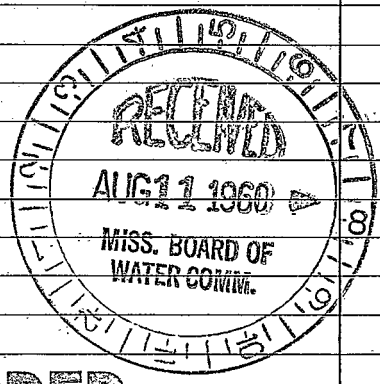

**CODED**

If YES depth of formation \_\_\_\_\_.

Why \_\_\_\_\_.

Drillers Remarks: \_\_\_\_\_.

(Use Back Side)

Well No. 1

