

Tippah
B18
10-66

MISSISSIPPI
BOARD OF WATER COMMISSIONERS
416 North State Street
Jackson, Mississippi 39201

WATER WELL DRILLERS LOG

10-20-1966 Robert M. Wilson Tippah
date well completed firm name county well located

LANDOWNER: Walter Carpenter

Pocahontas

Miss

(mailing address)

WELL LOCATION:

sec. 23 T 1 N R 4 E
3 miles N of Wake's Store
(distance) (direction) (nearest town)

WELL PURPOSE: none
(home, irrigation, municipal, industrial)


WELL COMPLETION DATA:

- (1) diameter (inches) 4"
- (2) total depth (feet) 154'
- (3) static water level (feet) 125' ^{below} above top of ground.
- (4) casing Plastic, 150' (material) (depth)
4" (size) if telescope see back.
- (5) screen 4' 150' (length) (depth to top)
20 gals. (size) (material) Bud Pac Slotted Pipe
- (6) pump 1/2 (HP) (yield gpm)
Elect. (type power)
- (7) electric log NO (yes or no)
(organization running log)
- (8) how well bottom plugged 4"
Plastic cap

description of formations encountered

from to

Red clay	0	10
Red sand	10	20
Red sand & rock	20	40
Blue clay & sand	40	50
Blue clay	50	100
Barren sand & rock	100	140
Barren sand	140	155

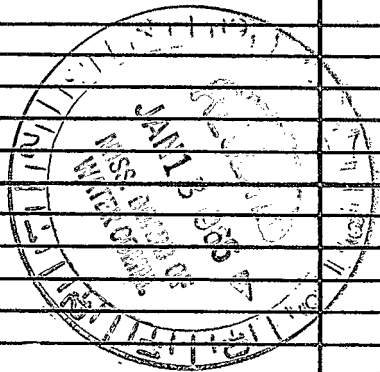

DRILLERS REMARKS:

If well telescopes please sketch and show depths.

GROUND LEVEL

SECTION _____

Please indicate well location X.

ADDITIONAL INFORMATION

If more than one screen, show locations of each on sketch.