

Tippah
 B19
 9-67

MISSISSIPPI
 BOARD OF WATER COMMISSIONERS
 416 North State Street
 Jackson, Mississippi 39201

WATER WELL DRILLERS LOG

9-6 1967 Robert Wilson Tippah
 date well completed firm name county well located

LANDOWNER: Jan Carter
 Locahontas St.
 Miss.
 (mailing address)


description of formations encountered	from	to
Red Clay	0	20
Blue Clay & Rock	20	48
Blue Clay	48	60
Red Sand	60	80
White Clay & Rock	80	100
Red Sand	100	140
Blue Sand	140	150
Blue Sand white clay Rock and Blue Sand	150	160

WELL LOCATION:
 sec. 17 T 1 N R 4 E
 (distance) miles (direction) of (nearest town)
 Exact location unknown
 3 East Brownville

WELL PURPOSE:
 (home, irrigation, municipal, industrial)


- WELL COMPLETION DATA:
- (1) diameter (inches) 4"
 - (2) total depth (feet) 160'
 - (3) static water level (feet) 140' below top of ground
 - (4) casing Plastic, 152' (material) (depth)
 4" (size) if telescope see back.
 - (5) screen 8' 152' (length) (depth to top)
 4" Gravel Pack (size) (material)
 - (6) pump 1/2 10 (HP) (yield gpm)
 Elect. (type power)
 - (7) electric log (yes or no)
 - (organization running log)
 - (8) how well bottom plugged 4"
 Plastic Cap

DRILLERS REMARKS:

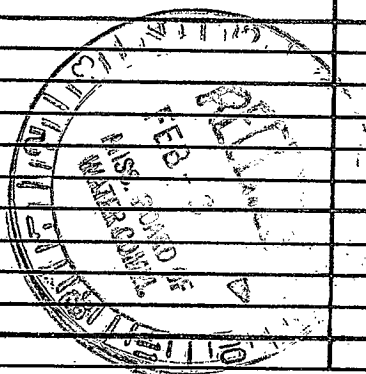

If well telescopes please sketch and show depths.

GROUND LEVEL

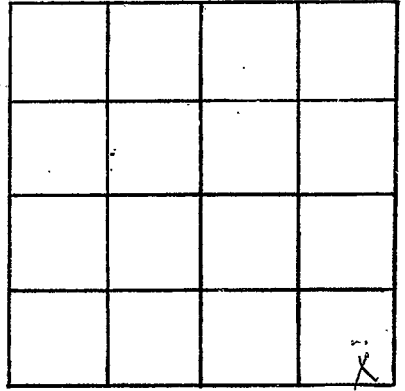

SECTION 4K

Please indicate well location X.

ADDITIONAL INFORMATION

If more than one screen, show locations of each on sketch.