

TIPPAH
 B 20
 10-11-71

MISSISSIPPI
 BOARD OF WATER COMMISSIONERS
 416 North State Street
 Jackson, Mississippi 39201

WATER WELL DRILLERS LOG

date well completed 10-11-1971 firm name Robert W. Wilson county well located Tippah

LANDOWNER: Earl Spencer

Wa Inant

Miss

(mailing address)

WELL LOCATION:

sec. 22 T 1 N R 4 E
 (S) (W)

(distance) miles (direction) of (nearest town)

WELL PURPOSE:
 (home, irrigation, municipal, industrial)

WELL COMPLETION DATA:

- (1) diameter (inches) 4
- (2) total depth (feet) 135
- (3) static water level (feet) 75 below top of ground.
- (4) casing Plastic 135
 (material) (depth)
- 4 if telescope see back.
 (size)
- (5) screen 4 135
 (length) (depth to top)
- 4 Plastic
 (size) (material)
- (6) pump 3/4 10
 (HP) (yield gpm)
- Electric
 (type power)
- (7) electric log ✓
 (yes or no)

(organization running log)

(8) how well bottom plugged ✓
Plastic Cap

DRILLERS REMARKS:

description of formations encountered	from	to
<u>Top Clay</u>	<u>0</u>	<u>5</u>
<u>Red Sand</u>	<u>5</u>	<u>20</u>
<u>Red Sand & Clay</u>	<u>20</u>	<u>40</u>
<u>Blue Clay & Rock</u>	<u>40</u>	<u>66</u>
<u>Rock</u>	<u>66</u>	<u>74</u>
<u>Blue Clay & rock</u>	<u>74</u>	<u>100</u>
<u>Stream Sand</u>	<u>100</u>	<u>139</u>


CODED

FER - 3 1972

MISSISSIPPI
 BOARD OF WATER COMMISSIONERS

If well telescopes please sketch and show depths.

GROUND LEVEL

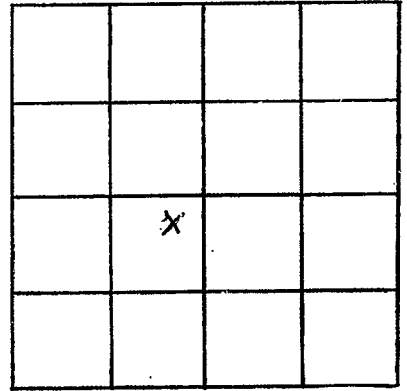

SECTION 22

Please indicate well location X.

ADDITIONAL INFORMATION

A series of horizontal lines for writing additional information, starting below the 'ADDITIONAL INFORMATION' header and extending down to the bottom of the page.

If more than one screen, show locations of each on sketch.