

MISSISSIPPI
BOARD OF WATER COMMISSIONERS
416 North State Street
Jackson, Mississippi 39201

CODED

WATER WELL DRILLERS LOG

TIPPAH
B 22
11-8-72

11-8-72 1972 Robert W. Wilson Linger
date well completed firm name county/well located

LANDOWNER: Dale Barel
Walnut
Missis
(mailing address)

description of formations encountered	from	to
<u>Red clay</u>	<u>0</u>	<u>5</u>
<u>Brown sand</u>	<u>5</u>	<u>15</u>
<u>White sand + white clay</u>	<u>15</u>	<u>30</u>
<u>White clay + Brown sand</u>		
<u>sand</u>	<u>31</u>	<u>37</u>
<u>Blue clay + rocks</u>	<u>37</u>	<u>103</u>
<u>sand + rocks</u>	<u>103</u>	<u>110</u>
<u>Blue clay + sand + rocks</u>	<u>110</u>	<u>120</u>
<u>Blue clay + rocks</u>	<u>120</u>	<u>135</u>
<u>Green sand + rocks</u>	<u>135</u>	<u>165</u>

WELL LOCATION:
sec 26 T 1 N 4 E
5 W
_____ miles _____ of _____
(distance) (direction) (nearest town)

WELL PURPOSE:
(home, irrigation, municipal, industrial)

WELL COMPLETION DATA:
(1) diameter (inches) 4
(2) total depth (feet) 152
(3) static water level (feet) 135 below above top of ground.
(4) casing _____, _____, _____
(material) (depth)
_____ if telescope see back.
(size)
(5) screen 10, 142
(length) (depth to top)
4, gravel pack
(size) (material)
(6) pump 3/4, 10
(HP) (yield gpm)
electric
(type power)
(7) electric log _____
(yes or no)

(organization running log)
(8) how well bottom plugged Hard
plastic cap


DRILLERS REMARKS:

NOV 2 1972

MISS. Bd. Of
WATER COMM.

If well telescopes please sketch and show depths.

GROUND LEVEL

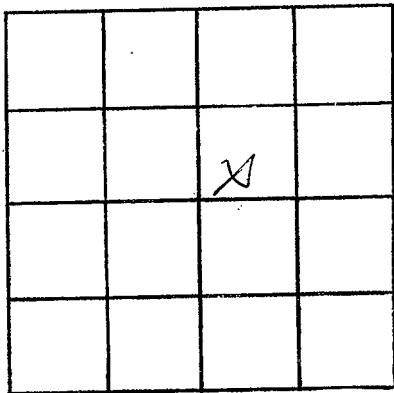

SECTION 26

Please indicate well location X.

ADDITIONAL INFORMATION

If more than one screen, show locations of each on sketch.