

B 23
 TIPPAH
 7-6-73
 7-6

MISSISSIPPI
 BOARD OF WATER COMMISSIONERS
 416 North State Street
 Jackson, Mississippi 39201

CODED

WATERWELL DRILLERS LOG

W. J. Medley Tippah

date well completed 19 _____ firm name _____ county well located _____

LANDOWNER:
Christ Temple
Walnut
 (mailing address)

description of formations encountered	from	to
<i>blue rock</i>	<i>14</i>	<i>126</i>
<i>blue "</i>	<i>126</i>	<i>120</i>
<i>rock + gravel</i>	<i>140</i>	<i>290</i>

WELL LOCATION:
 sec. *31* T *1* N R *4* E
2 miles *W* of *Walnut*
 (distance) (direction) (nearest town)

WELL PURPOSE:
 (home, irrigation, municipal, industrial)

WELL COMPLETION DATA:

- (1) diameter (inches) 290
- (2) total depth (feet) 85
- (3) static water level (feet) 130 below above top of ground
- (4) casing _____ (material) _____ (depth) _____
(size) If telescope see back.
- (5) screen 0 (length) _____ (depth to top) _____
(size) 5 (material) _____
- (6) pump E (HP) _____ (yield gpm) _____
(type power) _____
- (7) electric log _____ (yes or no) _____
(organization running log) _____
- (8) how well bottom plugged _____


PAID

AUG 22 1973

DRILLERS REMARKS: _____

If well telescopes please
sketch and show depths.

GROUND LEVEL

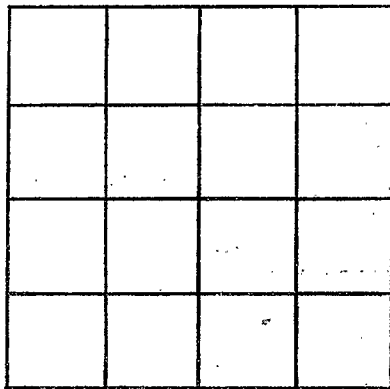

SECTION _____

Please indicate well location X.

ADDITIONAL INFORMATION

If more than one screen,
show locations of each on sketch.