

F.H.A.

840.00  
4200  
8200

MISSISSIPPI  
BOARD OF WATER COMMISSIONERS  
416 North State Street  
Jackson, Mississippi 39201

CODED

WATER WELL DRILLERS LOG

B 24
TIPPAH
7-12-73
712
1973

J.T. McArthur

Tippah

date well completed

firm name

county well located

LANDOWNER:  
Orville Brown  
Walnut  
(mailing address)

description of formations encountered	from	to
Clay	0	33
" & rock	33	110
blue "	110	180
rock & sand	180	320

WELL LOCATION:  
sec. 31 T 1 N R 4 E  
4 miles W of Walnut  
(distance) (direction) (nearest town)

WELL PURPOSE:  
(home, irrigation, municipal, industrial)

WELL COMPLETION DATA:

(1) diameter (inches) 4

(2) total depth (feet) 320

(3) static water level (feet) 80 below top of ground.

(4) casing P 140 (material) (depth)

(size) if telescope see back.

(5) screen (length) (depth to top)

(size) (material)

(6) pump 1/2 6 (HP) (yield gpm)

E (type power)

(7) electric log (yes or no)

(organization running log)

(8) how well bottom plugged

CODED


AUG 22 1973

DRILLERS REMARKS:

MIS  
WAJ

If well telescopes please sketch and show depths.

GROUND LEVEL

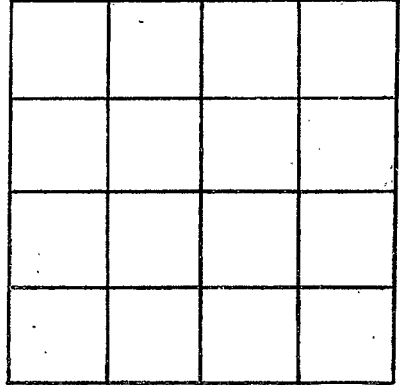

SECTION \_\_\_\_\_

Please indicate well location X.

ADDITIONAL INFORMATION

If more than one screen,  
show locations of each on sketch.