

TIPPAN
B 26
3-2-75

MISSISSIPPI
BOARD OF WATER COMMISSIONERS
416 North State Street
Jackson, Mississippi 39201

850 00
45 00

WATER WELL DRILLERS LOG

5 2 19 75 J T Walker Tippah
date well completed firm name county well located

2 1/2 mi NE of Walnut

LANDOWNER: Acorn
Copplman
Dinkins A H
(mailing address)

description of formations encountered	from to	
Clay	0	28
Shale	28	70
Clay	70	105
10 wt. sand	105	160
Clay	160	170

WELL LOCATION:
sec. 23 T 1 N R 4 E
3 miles SE of Winnas
(distance) (direction) (nearest town)

WELL PURPOSE:
(home, irrigation, municipal, industrial)

- WELL COMPLETION DATA:
- (1) diameter (inches) 4
 - (2) total depth (feet) 170
 - (3) static water level (feet) 110 below top of ground
 - (4) casing P (material), 170 (depth)
 - (5) screen 10 (length), 160 (depth to top)
 - (6) pump 5 (HP), 6 (yield gpm)
 - (7) electric log (yes or no) _____
 - (8) how well bottom plugged cap


DRILLERS REMARKS:

RECEIVED

MAR 20 1975

If well telescopes please sketch and show depths.

GROUND LEVEL

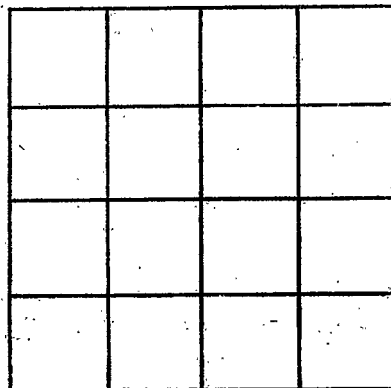

SECTION _____

Please indicate well location X.

ADDITIONAL INFORMATION

If more than one screen, show locations of each on sketch.