

TIPPAH

B27

7-82

MISSISSIPPI BOARD OF WATER COMMISSIONERS

416 North State Street

Jackson, Mississippi 39201

CODED

WATER WELL DRILLERS LOG

7

date well completed

1982

Herndon Well & Supply, Inc.

firm name

Tippah

county well located

LANDOWNER: Town of Walnut	description of fomations encountered	from	to
Walnut, MS 38683 (mailing address)	Brown Sandy Clay	0	10
WELL LOCATION: sec. 32 T 01 N S R 04 E	Blue Sand	10	30
(distance) miles (direction) of (nearest town)	Blue Sandy Clay	30	90
WELL PURPOSE: Municipal (home, irrigation, municipal, industrial)	Rock	90	95
WELL COMPLETION DATA: (1) diameter (inches) 10"	Shale	95	105
(2) total depth (feet) 952'	Blue Sandy Clay	105	123
(3) static water level (feet) 157' below top of ground.	Hard Rock	123	124
(4) casing Steel 872.73 (material), (depth) 10" (size) If telescope see back.	Red Sand	124	140
(5) screen 66.25 (length), 866.15 (depth to top) 6" (size), Stainless Steel (material)	Hard Rock	140	142
(6) pump 40 (HP), 317 (yield gpm)	Brown Sandy Clay	142	152
electric (type power)	Hard Rock	152	154
(7) electric log yes (yes or no)	Sand, Coarse & Gravel	154	175
(8) how well bottom plugged 6" BWV	Hard Rock	175	180
DRILLERS REMARKS:	Sand w/streaks of Clay	180	283
	Blue Clay	283	295
	Sand w/Clay Streaks, Shale	295	400
	Blue Clay	400	760
	Sandy Blue Clay	760	803
	Sand	803	845
	Sandy Blue Clay	845	860
	Sand	860	890
	Sandy Blue Clay	890	910
	Sand	910	948
	Sandy Clay	948	974
	Tight Sand	974	1023
	Hard Rock	1023	

CODED

DEPT. OF NATURAL RESOURCES BUREAU OF LAND & WATER RESOURCES

SEP 20 1982

RECEIVED

All telescopes please sketch and show depths.

GROUND LEVEL

10" CASING

157' STATIC

Top of LAP  
799.90

Top of Top Screen  
866.15'

Bottom of Top Screen  
891.70

Top of Bottom Screen  
911.30'


Bottom Screen  
952'



Blank

26"  
Under ream

12-24  
GRAVEL

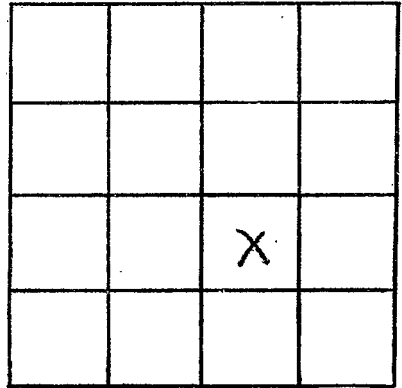

SECTION 3a

Please indicate well location X.

ADDITIONAL INFORMATION

If more than one screen,  
show locations of each on sketch.