

Lippah  
 County: Blount  
 Permit #: \_\_\_\_\_  
 Driller: \_\_\_\_\_  
 Date drilling completed: 4/5/06

**State Well Report**  
**Part 1 - Driller's Log**  
 Mississippi Department of Environmental Quality  
 Office of Land and Water Resources  
 P.O. Box 10631  
 Jackson, MS 39289-0631  
 (601)961-5210  
 (601)354-6938 (fax)

**For Office Use Only:**  
 Aquifer: \_\_\_\_\_  
 Well #: B-31  
 L. S. Elevation: \_\_\_\_\_  
 E-log #: \_\_\_\_\_

*State Law requires that this report be prepared by the license holder responsible for the work and filed with the Department at the above address within 30 days of completion of drilling of the well or borehole.*

<b>Information on Well Owner</b> (Landowner if borehole is not for a water well)		<b>Well or Borehole Location</b>	
Owner Name: <u>Name of Jesus Church</u>	Latitude: _____	Longitude: _____	
Mailing Address: <u>150 CR 279</u>	Method of Lat/Long (circle one): Conventional Survey, USGS quad, Hand-held GPS, Survey-grade GPS		
<u>Walnut, MS 38683</u>	1/4 _____	1/4 Sec <u>31</u>	Twn <u>15</u> Rng <u>4E</u>
City State Zip Code	Distance <u>3</u> Miles	Direction <u>East</u> of	Nearest Town <u>Walnut</u>
Telephone No. (____)			

**Well / Borehole Data**

Date drilling started: 4/5/06 Date drilling completed: 4/5/06 Hole depth: 135 Hole diameter: 4"

Location of the source of any surface water used for drilling: none

Method of dosing and volume of Chlorine used in drilling and development: hand top granular

Logs run (circle all applicable): No log run Electric Gamma Ray Density Sonic Neutron Other: \_\_\_\_\_

Name of organization running log(s): \_\_\_\_\_

Purpose of borehole (check one): Water Well  Geotechnical/Geological Investigation \_\_\_\_\_ Ground Source Heat Pump \_\_\_\_\_

Seismic Survey \_\_\_\_\_ Other (describe) \_\_\_\_\_

*If drilling is not related to water well construction, skip the remainder of this block*

Purpose of Well (check one): Home \_\_\_\_\_ Industrial \_\_\_\_\_ Public Supply \_\_\_\_\_ Irrigation \_\_\_\_\_ Fish Culture \_\_\_\_\_ Other: Church

If a flowing well, method of flow regulation: Valve \_\_\_\_\_ Other (describe) \_\_\_\_\_

Static Water Level: 70 feet above or below (circle one) land surface Date measured: 4/7/06

Method of Measurement (circle one) steel tape electric tape air line other: \_\_\_\_\_

Well depth: 135 Well grouted to a depth of 10 feet Type of grout (circle one): Neat Cement Bentonite Mix

Casing length: 125 feet Casing diameter: 4 inches Type of casing: PVC

Screen length: 10 feet Screen diameter: 4 inches Type of screen: PVC

Screen slot size: .013 inches Setting depth: From 125 feet to 135 feet

Type of completion (circle all applicable): Gravel packed Underreamed Telescoped Open hole Natural Development

Other (describe): \_\_\_\_\_

Top of lap pipe or reduction in casing: \_\_\_\_\_ feet. *If telescoped or more than one screen, describe on next page*


Form: OLWR-SWR-1A  
**RECEIVED**  
 APR 25 2006  
 BY: OLWR

**B-31**

The sketch below only required for water wells

If well telescopes, show depths on sketch.

Ground Level \_\_\_\_\_

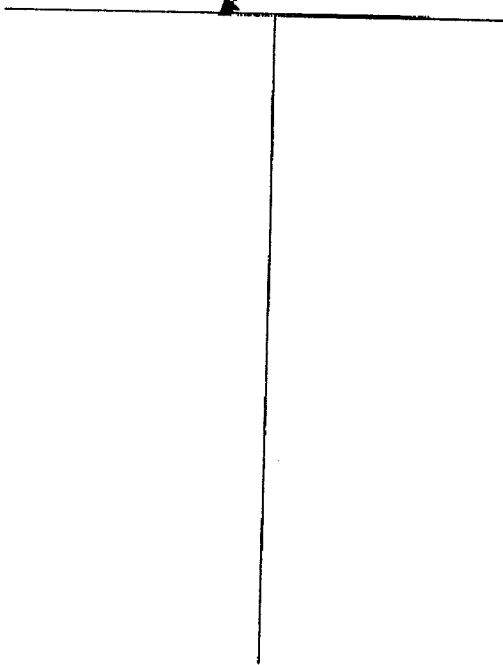

If more than one screen, show location of each on sketch

Description of formations encountered must be provided for all wells and boreholes, unless specifically exempted by regulations

Description of Formations Encountered	From (depth)	To (depth)
	Ground Level	
clay	0	10
sand	10	40
white clay	40	80
sand	80	110
clay	110	115
sand	115	135

Sketch the property layout and include the following: 1) the well location; 2) any permanent structures on the property that may aid in locating the well; 3) any roads, power lines, or other items that may aid in locating the property and the well; 4) a north arrow.

Landowner Name: \_\_\_\_\_

I certify that the well/borehole was drilled, constructed, and completed in accordance with all applicable requirements of the Mississippi Department of Environmental Quality and the Mississippi Department of Health regulations, if applicable, and state laws.

Form: OLWR-SWR-1A

**Bernard Frost - 0217 4-20-06**

*Bernard Frost*

Print Name of Responsible Licensee and License No.

Date

Signature of Licensee

**RECEIVED**  
APR 25 2006  
**BY: OLWR**

# STATE WELL REPORT

## Part 2

**Pump Installer's Completion Report**  
 Mississippi Department of Environmental Quality  
 Office of Land and Water Resources  
 P.O. Box 10631  
 Jackson, MS 39289-0631  
 (601)961-5210  
 (601)354-6938 (fax)

County: Greene  
 Permit #: \_\_\_\_\_  
 Driller: Frank S. Johnson  
 Date completed: 4/7/06  
*Copy information from block on Part 1*

**For Office Use Only:**  
 Aquifer: \_\_\_\_\_  
 Well #: B-31  
 Elevation: \_\_\_\_\_

*This part of the report must be completed by a licensed water well contractor or a licensed pump installer. A copy of Part 1 of the report must be attached and both parts filed with the Department at the above address within 30 days of well completion.*

Well Owner Information	Well Location
Owner Name: <u>Name of Jesus Church</u>	Latitude: _____ Longitude: _____
Mailing Address: <u>150 CR 279</u>	Method of Lat/Long (check one): Conventional Survey _____ USGS quad _____ Hand-held GPS _____ Survey-grade GPS _____
<u>Walnut</u> , <u>MS</u> <u>38683</u>	_____ 1/4 _____ 1/4 Sec <u>31</u> T <u>15</u> R <u>4E</u>
City State Zip Code	Distance Direction Nearest Town <u>3</u> Miles <u>East</u> of <u>Walnut</u>
Telephone No. (_____) _____	

Pump Type Circle one	Power Type Circle one
Air Lift Jet <input checked="" type="radio"/> Submersible	Diesel Engine Gasoline Engine Natural Gas
Bucket Piston Turbine	<input checked="" type="radio"/> Electric Motor Hand Tractor PTO
Centrifugal Rotary Flowing Well	Windmill Other (specify): _____
Other (specify): _____	Horse Power Rating of Motor: <u>1.5</u>
Date Pump Installed: <u>4/7/06</u>	Setting Depth: <u>100</u> feet
Rated Pump Capacity: <u>20</u> Gallons Per Minute	Number of Stages: <u>11</u>

Pump Test Data	Method of Measuring Water Level Circle one
Date Well Tested: <u>4/7/06</u>	Air Line Electric Measuring Line Steel Tape
Static Water Level (A): <u>70</u> Feet Below Land Surface	Other (specify): <u>PVC Pipe</u>
Pumping Water Level (B): <u>100</u> Feet Below Land Surface	For flowing well, measured shut in head: _____ feet
Drawdown [(B) - (A)]: _____ Feet Below Land Surface	Well yielded _____ GPM with a drawdown of _____ feet after _____ hours of pumping
Test Pumping Rate: <u>20</u> Gallons Per Minute	
Duration of Pump Test (minimum 4 hours): _____ hours	

I HEREBY CERTIFY that the above statements are true to the best of my knowledge.

Print Name of Pump Installer and License No. (if applicable) \_\_\_\_\_ Signature of Pump Installer \_\_\_\_\_

Form: **RECEIVED**  
 APR 25 2006  
 BY: OLWR