

Tippah
 B¹¹ 200
 8-12-75

MISSISSIPPI
 BOARD OF WATER COMMISSIONERS
 416 North State Street
 Jackson, Mississippi 39201

WATER WELL DRILLERS LOG

8-12-75 19 Robert W. Wilson Tippah
 date well completed firm name county well located

LANDOWNER:

James Shorton

Walnut, miss
 (mailing address)

WELL LOCATION:

sec. 20 T-1 N-5 R-4E W
 (distance) miles (direction) of (nearest town)

WELL PURPOSE:

(home, irrigation, municipal, industrial)

WELL COMPLETION DATA:


- (1) diameter (inches) 4
- (2) total depth (feet) 249
- (3) static water level (feet) 120 below top of ground.
- (4) casing 4 239
 (material) (depth)
4 If telescope see back.
 (size)
- (5) screen 10 10
 (length) (depth to top)
10 gravel packed
 (size) (material)
- (6) pump 3/4 10
 (HP) (yield gpm)
electric
 (type power)
- (7) electric log (yes or no)
- (organization running log)
- (8) how well bottom plugged 4"
plastic

description of formations encountered

from to

<u>Blue clay + red Sand</u>	<u>0</u>	<u>15</u>
<u>white clay</u>	<u>15</u>	<u>30</u>
<u>Blue clay</u>	<u>30</u>	<u>165</u>
<u>Blue clay & Rocks</u>	<u>165</u>	<u>180</u>
<u>Blue clay</u>	<u>180</u>	<u>188</u>
<u>Rocks</u>	<u>188</u>	<u>200</u>
<u>Blue clay & Rocks</u>	<u>200</u>	<u>220</u>
<u>Green sand & Rocks</u>	<u>220</u>	<u>255</u>

DRILLERS REMARKS:

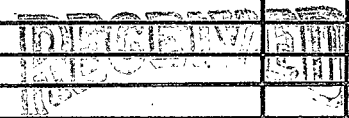

MAY 13 1976

If well telescopes please sketch and show depths.

GROUND LEVEL

X			

SECTION 20

Please indicate well location X.

ADDITIONAL INFORMATION

If more than one screen,
show locations of each on sketch.