

Tippah  
B 2001  
3-17-76

MISSISSIPPI  
BOARD OF WATER COMMISSIONERS  
416 North State Street  
Jackson, Mississippi 39201

WATER WELL DRILLERS LOG

3-17 1976  
date well completed

Roberts W. Wilson  
firm name

Tippah  
county well located

LANDOWNER:

Donald Grubbs

Pearkentes, Tenn.  
(mailing address)

WELL LOCATION:

sec. 26 T 1 N R 4 E  
2 S 2 W  
miles of  
(distance) (direction) (nearest town)

WELL PURPOSE:

(home, irrigation, municipal, industrial)

WELL COMPLETION DATA:

- (1) diameter (inches) 4
- (2) total depth (feet) 301
- (3) static water level (feet) 260 below above top of ground.
- (4) casing 4" (material) 291 (depth)  
4" (size) if telescope see back.
- (5) screen 10" (length) 291 (depth to top)  
4" (size) gravel packed (material)
- (6) pump 1 (HP) (yield gpm)  
electric (type power)
- (7) electric log (yes or no)
- (organization running log)
- (8) how well bottom plugged 4"  
plastic cap

description of formations encountered

from

to

Red clay & Red Sand	0	15
Red Sand & Rocks	15	30
Red Sands (white clay)	30	45
white Sand	45	60
white Sands Rocks	60	75
white Sands & white clay	75	125
white Sand	125	175
white Sands & blue clay	175	180
white Sand	180	185
white Sands & blue clay	185	195
white Sand	195	205
Blue clay & Sand Rocks	205	225
Blue Clay	225	270
gray Sand	270	305


MAY 12 1976

MISS. Bd. OF WATER COMMISSIONERS

DRILLERS REMARKS:

If well telescopes please sketch and show depths.

GROUND LEVEL

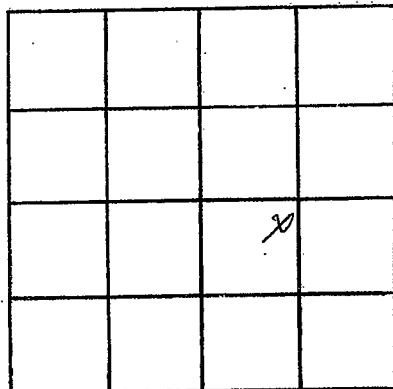

SECTION 26

Please indicate well location X.

ADDITIONAL INFORMATION

If more than one screen, show locations of each on sketch.