

**MISSISSIPPI
BOARD OF WATER COMMISSIONERS
416 North State Street
Jackson, Mississippi 39201
WATER WELL DRILLERS LOG**

Tippah
B 2003
7/9/77

7-9 date well completed 1977 Wilson Well Co. Inc. firm name Tippah county/well located

LANDOWNER:
Billy Wexler
P.O. Walnut, Miss
(mailing address)

WELL LOCATION:
sec. 36 T. 1 N. R. 40 E. W.
_____ miles _____ of _____
(distance) (direction) (nearest town)

WELL PURPOSE:
(home, irrigation, municipal, industrial)

WELL COMPLETION DATA:

(1) diameter (inches) 4

(2) total depth (feet) 124

(3) static water level (feet) 75 below above top of ground.

(4) casing _____ (material) 114 (depth) _____ (size) If telescope see back.

(5) screen _____ (length) _____ (depth to top) _____ (size) gravel packed (material)

(6) pump 3/4 (HP) 10 (yield gpm) _____ (type power) electric

(7) electric log _____ (yes or no) _____ (organization running log)

(8) how well bottom plugged 4" plaster cap

description of formations encountered	from	to
<u>Red clay + Red Sand</u>	<u>0</u>	<u>15</u>
<u>yellow Sand</u>	<u>15</u>	<u>30</u>
<u>Yellow Sand + Brown Sand</u>	<u>30</u>	<u>42</u>
<u>Rock</u>	<u>42</u>	<u>45</u>
<u>Brown Sand + Rock</u>	<u>45</u>	<u>60</u>
<u>Brown Sand + Red Rock</u>	<u>60</u>	<u>75</u>
<u>Red Sand + Rock</u>	<u>75</u>	<u>90</u>
<u>Yellow Sand + Rock</u>	<u>90</u>	<u>105</u>
<u>Yellow Sand</u>	<u>105</u>	<u>124</u>


RECEIVED
DEC 21 1977

DRILLERS REMARKS:

MISS. Bd. OF WATER COMMISSIONERS

If well telescopes please sketch and show depths.

GROUND LEVEL

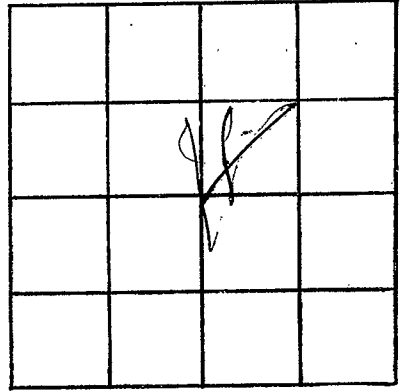

SECTION 36

Please indicate well location X.

ADDITIONAL INFORMATION

If more than one screen, show locations of each on sketch.