

Tippah
B 2004
7-11-77

MISSISSIPPI
BOARD OF WATER COMMISSIONERS
416 North State Street
Jackson, Mississippi 39201
WATER WELL DRILLERS LOG

7-11-77 19 22 Wilson Well Co. Inc. Tippah
date well completed firm name county well located

LANDOWNER:

R.C. Crum

description of formations encountered

from to

Rt. 3 Walnut Mesa.
(mailing address)

Red. clay 0 10
white clay & Sand 10 30
yellow Sand 30 60
Brown Sand & Rocks 60 120

WELL LOCATION:

sec. 26 T 1 N R 4 E
S W

_____ miles _____ of _____
(distance) (direction) (nearest town)

WELL PURPOSE:

(home, irrigation, municipal, industrial)

WELL COMPLETION DATA:

- (1) diameter (inches) 4
(2) total depth (feet) 119
(3) static water level (feet) 20 below above top of ground.

(4) casing _____ / _____
(material) (depth)
(size) If telescope see back.

(5) screen 10 / _____
(length) (depth to top)
(size) gravel packed (material)

(6) pump 3/4 / _____
(HP) (yield gpm)
electric
(type power)

(7) electric log _____
(yes or no)

_____ (organization running log)

(8) how well bottom plugged H"
plastic cap


DRILLERS REMARKS:

RECEIVED
DEC 21 1977

MISS. BD. OF WATER COMMISSIONERS
MISS. BD. OF WATER COMMISSIONERS

If well telescopes please sketch and show depths.

GROUND LEVEL

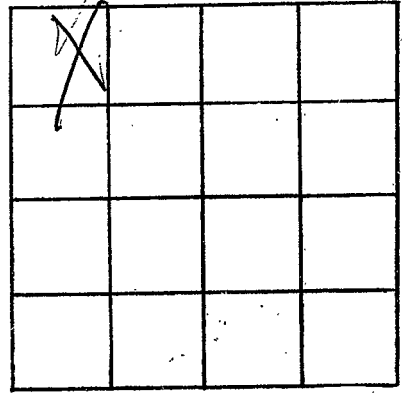

SECTION 26

Please indicate well location X.

ADDITIONAL INFORMATION

Lined area for additional information.

If more than one screen, show locations of each on sketch.