

Tippah
B 2005
7/11/77

MISSISSIPPI
BOARD OF WATER COMMISSIONERS
416 North State Street
Jackson, Mississippi 39201
WATER WELL DRILLERS LOG

July 11 1977 Wilson Well Co. Inc. Tippah
date well completed firm name county well located

LANDOWNER: P. J. Prince
Walnut, Miss.
(mailing address)

description of formations encountered	from	to
Red Clay & Red Sand	0	15
Red Sand & yellow Sand	15	30
Brown Sand (concrete)	30	135

WELL LOCATION:
sec. 34 T 1 N R 4 E
S W
miles of (distance) (direction) (nearest town)

WELL PURPOSE:
(home, irrigation, municipal, industrial)

- WELL COMPLETION DATA:
- (1) diameter (inches) 4
 - (2) total depth (feet) 131
 - (3) static water level (feet) 90 below above top of ground.
 - (4) casing (material) 131 (depth) If telescope see back. (size)
 - (5) screen 10 (length) (depth to top) (size) ground rock (material)
 - (6) pump 3/4 (HP) 10 (yield gpm) electric (type power)
 - (7) electric log (yes or no)
- (organization running log)

(8) how well bottom plugged 4" plastic cap


DRILLERS REMARKS:

RECEIVED
DEC 21 1977

MISS. BD. OF WATER COMMISSIONERS

If well telescopes please sketch and show depths.

GROUND LEVEL

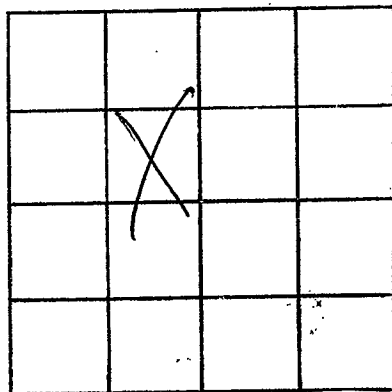

SECTION 34

Please indicate well location X.

ADDITIONAL INFORMATION

If more than one screen,
show locations of each on sketch.