

Tippah  
 Boone  
 7/12/77

MISSISSIPPI  
 BOARD OF WATER COMMISSIONERS  
 416 North State Street  
 Jackson, Mississippi 39201  
 WATER WELL DRILLERS LOG

2-12-19 22 A-Z Drills Tippah  
 date well completed firm name county well located

LANDOWNER:  
 A-Z Drills  
 Rt #3 Walnut, Miss  
 (mailing address)  
 WELL LOCATION:  
 sec. 23 T 1 N R 4 E  
 (distance) miles (direction) of (nearest town)

description of formations encountered	from	to
Red clay & white clay	0	15
white clay & sand	15	22
Blue clay	22	44
Rock	44	48
Blue clay	48	60
Blue clay & Rock	60	75
Blue clay & yellow clay	75	90
Blue clay & Sand	90	120
Blue clay	120	125
Blue clay & sand	125	135
white Sand fine	135	150
yellow white Sand coarse	150	165

WELL PURPOSE:  
 (home, irrigation, municipal, industrial)


WELL COMPLETION DATA:  
 (1) diameter (inches) 4  
 (2) total depth (feet) 165  
 (3) static water level (feet) 105 below top of ground.  
 (4) casing (material) (depth) 165  
 (size) if telescope see back.  
 (5) screen (length) (depth to top) 10  
 (size) (material) gravel packed  
 (6) pump (HP) (yield gpm) 3/4 10  
 (type power) electric  
 (7) electric log (yes or no)  
 (organization running log)

(8) how well bottom plugged 4"  
 plastic cap  
 DRILLERS REMARKS:

RECEIVED  
 DEC 21 1977  
 MISS. BD. OF WATER COMMISSIONERS

If well telescopes please sketch and show depths.

GROUND LEVEL

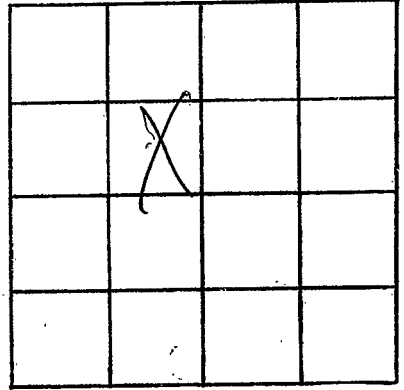

SECTION 23

Please indicate well location X.

ADDITIONAL INFORMATION

If more than one screen, show locations of each on sketch.