

TIPPAH

B 2007

3/27/78

MISSISSIPPI BOARD OF WATER COMMISSIONERS 416 North State Street Jackson, Mississippi 39201

WATER WELL DRILLERS LOG

3-27 1978 date well completed Wilson Well Co. Inc. firm name Tippah county well located

LANDOWNER:	description of formations encountered	from	to
(mailing address)			
Francis H. Littlemire	Red clay	0	20
RT # 1 Peachowles, TN	Blue clay	20	29
	Rocks	29	31
	Blue clay	31	45
	Blue clay & Rocks	45	60
	Blue clay	60	75
	Blue clay & white clay	75	90
	Blue clay	90	105
	Blue clay	105	115
	Blue clay & sand	115	123
	Brown sand & Rocks	123	160

LANDOWNER:

Francis H. Littlemire RT # 1 Peachowles, TN (mailing address)

WELL LOCATION:

sec. 23 T-1 N R-4E W (distance) miles (direction) of (nearest town)

WELL PURPOSE:

(home, irrigation, municipal, industrial)

WELL COMPLETION DATA:

- (1) diameter (inches) 4
- (2) total depth (feet) 160
- (3) static water level (feet) 130 below top of ground.
- (4) casing 4 (material) 160 (depth) 4 (size) if telescope see back.
- (5) screen 10 (length) 150 (depth to top) 4 (size) gravel packed (material)
- (6) pump 3/4 (HP) 10 (yield gpm) electric (type power)
- (7) electric log (yes or no)
- (8) how well bottom plugged 4" plastic cap

DRILLERS REMARKS:


RECEIVED

JUN 26 1978

MISS. BD. OF WATER COMM

If well telescopes please sketch and show depths.

GROUND LEVEL

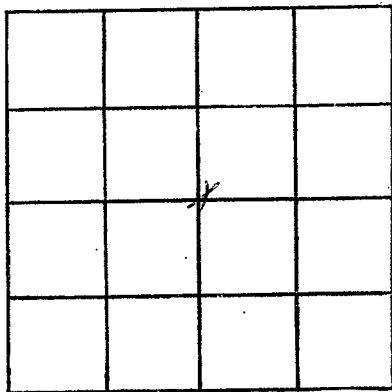

SECTION 23

Please indicate well location X.

ADDITIONAL INFORMATION

If more than one screen, show locations of each on sketch.