

TIPPAH

B 2008

3-28-78

MISSISSIPPI BOARD OF WATER COMMISSIONERS  
416 North State Street  
Jackson, Mississippi 39201

WATER WELL DRILLERS LOG

3-28-19 78 Wilson Well Co. Inc. Tipah  
date well completed firm name county well located

LANDOWNER:	description of formations encountered	from	to
<u>Billy C. Carter</u>	<u>Red clay white clay</u>	<u>0</u>	<u>20</u>
<u>Rt #1 Pa</u>	<u>Blue clay</u>	<u>20</u>	<u>21</u>
(mailing address)	<u>Rock</u>	<u>21</u>	<u>33</u>
WELL LOCATION:	<u>Blue clay</u>	<u>33</u>	<u>44</u>
sec. <u>23</u> T <u>1</u> N R. <u>4E</u>	<u>Rock</u>	<u>44</u>	<u>75</u>
(distance) miles (direction) of (nearest town) ?	<u>Blue clay white clay</u>	<u>75</u>	<u>90</u>
WELL PURPOSE:	<u>Brown Sand Rock</u>	<u>90</u>	<u>100</u>
(home, irrigation, municipal, industrial)	<u>Blue clay</u>	<u>100</u>	<u>105</u>
WELL COMPLETION DATA:	<u>Blue clay &amp; Rock</u>	<u>105</u>	<u>117</u>
(1) diameter (inches) <u>4</u>	<u>Blue clay &amp; Sand</u>	<u>117</u>	<u>120</u>
(2) total depth (feet) <u>158</u>	<u>yellow white sand Rock</u>	<u>120</u>	<u>120</u>
(3) static water level (feet) <u>100</u> below above top of ground.	<u>Brown Sand &amp; Rock</u>	<u>120</u>	<u>158</u>
(4) casing <u>4</u> (material) <u>148</u> (depth)			
<u>4</u> (size) if telescope see back.			
(5) screen <u>10</u> (length) <u>148</u> (depth to top)			
<u>4</u> (size) <u>gravel pack</u> (material)			
(6) pump <u>3/4</u> (HP) <u>10</u> (yield gpm)			
<u>electric</u> (type power)			
(7) electric log (yes or no)			
(organization running log)			
(8) how well bottom plugged <u>14"</u> <u>plastic cap</u>			
DRILLERS REMARKS:			


RECEIVED

JUN 26 1978

ER COMM

If well telescopes please sketch and show depths.

GROUND LEVEL

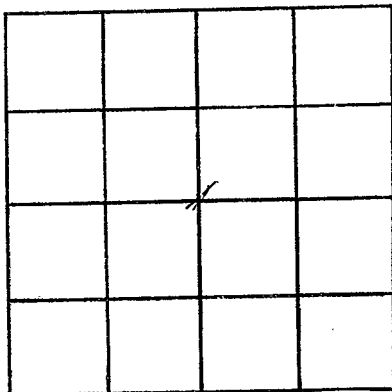

SECTION 23

Please indicate well location X.

ADDITIONAL INFORMATION

If more than one screen, show locations of each on sketch.