

TIPPAH
B 2007
9-26-78

MISSISSIPPI
BOARD OF WATER COMMISSIONERS
416 North State Street
Jackson, Mississippi 39201

WATER WELL DRILLERS LOG

9-26-1978
date well completed

W. J. Geoghegan Co., Inc.
firm name

TIPPAH
county well located

LANDOWNER: W. H. Sominow
Walnut, Miss.
(mailing address)

description of formations encountered	from to	
<u>Top Soil</u>	<u>0</u>	<u>10</u>
<u>white sand clay</u>	<u>10</u>	<u>60</u>
<u>fine white sand</u>	<u>60</u>	<u>120</u>
<u>Coarse white sand</u>	<u>120</u>	<u>140</u>

WELL LOCATION:
sec. 25 T 1 N R. 4E
2 miles ? of ?
(distance) (direction) (nearest town)

WELL PURPOSE:
(home, irrigation, municipal, industrial)

- WELL COMPLETION DATA:
- (1) diameter (inches) 4
 - (2) total depth (feet) 140
 - (3) static water level (feet) 80 below
top of ground.
 - (4) casing PVC, 120
(material) (depth)
4 if telescope see back.
(size)
 - (5) screen 20, 120
(length) (depth to top)
4, gravel packed
(size) (material)
 - (6) pump 3/4 HP, 400
(HP) (yield/gpm)
 - electrical
(type power)
 - (7) electric log
(yes or no)

(organization running log)
(8) how well bottom plugged 4"
plastic cap

DRILLERS REMARKS:


RECEIVED

OCT 23 1978

MISS. B. OF WATER COMMISSIONERS

If well telescopes please sketch and show depths.

GROUND LEVEL

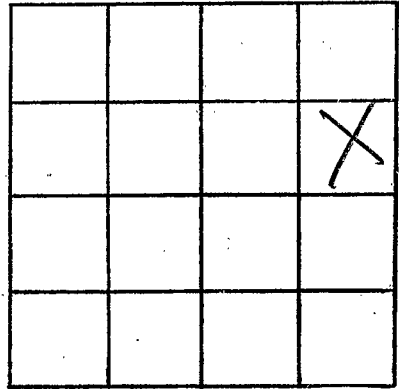

SECTION 25

Please indicate well location X.

ADDITIONAL INFORMATION

If more than one screen,
show locations of each on sketch.