

TIPPAH

B 2010

11-24-78

MISSISSIPPI  
BOARD OF WATER COMMISSIONERS  
416 North State Street  
Jackson, Mississippi 39201

WATER WELL DRILLERS LOG

11-24 1978  
date well completed

Robert W. Walker  
firm name

TIPPAH  
county well located


LANDOWNER:	description of formations encountered	from	to
<i>Dorsett Jones</i> <i>Box # 267 Walnut, Miss</i> (mailing address)			
	<i>Red Sand</i>	<i>15</i>	<i>30</i>
	<i>Blue clay</i>	<i>30</i>	<i>165</i>
	<i>Rock</i>	<i>165</i>	<i>173</i>
	<i>Rock &amp; Blue clay</i>	<i>173</i>	<i>195</i>
	<i>Blue clay + Green Sand</i>	<i>195</i>	<i>210</i>
	<i>Green Sand</i>	<i>210</i>	<i>235</i>
WELL LOCATION: sec. <i>31</i> T <i>1</i> N R <i>4</i> E <i>(S)</i> W			
(distance) miles (direction) of (nearest town)			
WELL PURPOSE: (home, irrigation, municipal, industrial)			
WELL COMPLETION DATA:			
(1) diameter (inches) <i>4</i>			
(2) total depth (feet) <i>230</i>			
(3) static water level (feet) <i>100</i> below top of ground.			
(4) casing (material) <i>4</i> (depth) <i>220</i>			
<i>4</i> (size) if telescope see back.			
(5) screen <i>10</i> (length) <i>220</i> (depth to top)			
<i>4</i> (size) <i>gravel packed</i> (material)			
(6) pump <i>3/4</i> (HP) <i>10</i> (yield gpm)			
<i>electric</i> (type power)			
(7) electric log (yes or no)			
(organization running log)			
(8) how well bottom plugged <i>4"</i> <i>plastic cap</i>			
DRILLERS REMARKS:			

RECEIVED  
JAN 15 1978

MISS. BD. OF WATER COMMISSIONERS

If well telescopes please sketch and show depths.

GROUND LEVEL

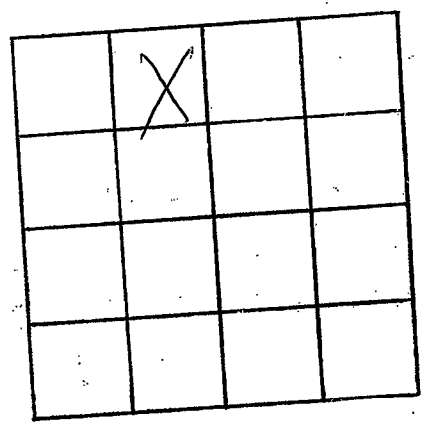

SECTION 3/

Please indicate well location X.

ADDITIONAL INFORMATION

If more than one screen, show locations of each on sketch.