

Tippah  
 B 2011  
 12-06-78

MISSISSIPPI  
 BOARD OF WATER COMMISSIONERS  
 416 North State Street  
 Jackson, Mississippi 39201

WATER WELL DRILLERS LOG

12-6 1978  
 date well completed

Wilson Well Co  
 firm name

Tippah  
 county well located

LANDOWNER:	description of formations encountered	from	to
Narry Epperson P.O. Box 234 Collierville, Tenn. (mailing address)			
WELL LOCATION: sec 33 T 1 N R 4 E (distance) miles of (direction) (nearest town)			
WELL PURPOSE: (home, irrigation, municipal, industrial)			
WELL COMPLETION DATA:			
(1) diameter (inches) 4			
(2) total depth (feet) 83			
(3) static water level (feet) 50 below top of ground.			
(4) casing (material) (depth) 173			
(size) if telescope see back.			
(5) screen (length) (depth to top) 10 13			
(size) (material) 4 gravel packed			
(6) pump (HP) (yield gpm) 1 15			
(type power) electric			
(7) electric log (yes or no)			
(organization running log)			
(8) how well bottom plugged 4" plastic cap			
DRILLERS REMARKS:			


RECEIVED

JAN 15 1978

MISS. BD. OF WATER COMMISSIONERS

If well telescopes please sketch and show depths.

GROUND LEVEL

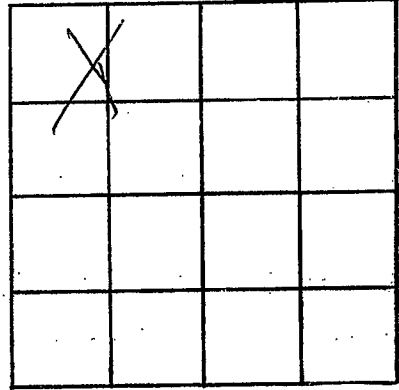

SECTION 33

Please indicate well location X.

ADDITIONAL INFORMATION

If more than one screen, show locations of each on sketch.